

SURVEY & REMONUMENTATION

MAR 04 1998

LIBER 172777-711

JN -9 97 | 24487

LAND CORNER RECORDATION CERTIFICATE
Filing Requirement of Act 74, Mich. P.A. 1970

Compliance with ACT 345, P.A. 1990

APPROVED ON: 4-16-97
OAKLAND COUNTY REMONUMENTATION PEER GROUP COMMITTEE


SECTION
For corners in

Table with columns: Oakland (County), Located in: Farmington Township, Corner Code #. Rows include Public Land Survey, Property Controlling in Section, and Miscellaneous Property in Sec.

\$ 7.00 MISCELLANEOUS RECORDING
\$ 2.00 REMONUMENTATION
9 JUN 97 12:23 P.M. RECEIPT# 94A
PAID RECORDED - OAKLAND COUNTY
LYNN D. ALLEN, CLERK/REGISTER OF DEEDS

Register of Deeds Stamp & File Number

- 4. Lot No.
5. Private Claims

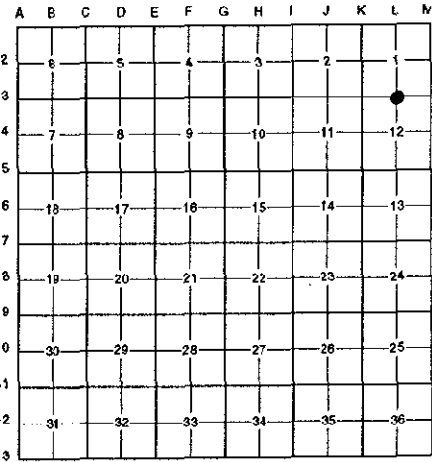

I, Randy Kolehouse, in a field survey on April 8, 1997, do hereby certify that under requirements of P.A. 74 Michigan P.A. of 1970, the corner points mentioned in lines 1 and 2 above were in conformance with regulations and rules therefore as required in the current manual of survey instructions of the United States Department of the Interior, Bureau of Land Management or by a decree of a Court of Law and/or that the corner points mentioned in lines 3, 4 and 5 above were in conformance with the rules of the Michigan Board of Land Surveyors or by a Decree of a Court of Law; established, re-established, monumented, re-monumented, recovered, found as expressed below:

NOTE: Not more than 4 corners, all in the same town and range, may be recorded on this certificate.

A. Description of original monument and accessories and/or subsequent restoration:

Table with columns: L-3, 1817, 1943, 1995, N/A, Wampler, McAlpine, Dunn, N/A, G.L.O. Notes, Supervisor's Plat of Wood Creek Farms L. 55 P. 34, L.C.R.C. L. 16832 P. 179, O.C. Tax Maps, Set Post, N/A, Set PK Nail in Asphalt Road, N/A

B. Description of corner evidence found and/or method applied in restoring or reestablishing corner:

L-3 Found a PK nail in the C/L of 13 Mile Road (bit.) running East and West, 60' South of a 1/2" rebar on the North right-of-way, as reestablished by Martin Dunn in 1995 using subdivisions of record and MDOT information. Using PK found, we also checked Supervisor's Plat of Wood Creek Farms and found angle to be very close at L-3 W-S-E (R = 179°50'00", M = 179°50'05"). Checks closely distances as shown in recorded plats.

- L.C.R.C. L. 16832 P. 179 (1995)
N 27° W 36.59' PK Nail w/Tag on East Face of Util. Pole (m. 36.54')
N 12° W 60.21' Nail w/Tag on East Face of Util. Pole (m. 60.23')
N 70° E 94.61' Iron Rod at NW Rim of GV&W and S Face of Walk

Measure West 2655.59' to K-3 (G.L.O. = 2640.0') (Sup. Plat Wood Creek Farms = 2655.26') (M. Dunn = 2655.53') (MDOT = 2656.06')
Measure East 2641.42' to M-3 (G.L.O. = 2640.0') (Sup. Plat Wood Creek Farms = 2642.4' (Calc.)) (M. Dunn = 2641.53')

C. Description of monument for corner and accessories established to perpetuate locating the position of the corner:

L-3 Replaced PK nail with a 5/8" x 24" rebar with brass cap stamped "Oakland County Remonumentation P.S. #25854." Also set a new monument box.

- PK Nail & Tag Stamped "Oakland Co. Remonumentation P.S. #25854" in E'ly Side Util. Pole S 33° W 36.54' Iron with Cap (Trav. Pt. #30081) on NW Side G.V.&W. at B/Walk S 65° E 94.61'
PK Nail & Tag Stamped "Oakland Co. Remonumentation P.S. #25854" in SW'ly Side Util. Pole S 69° E 100.19'
PK Nail & Tag Stamped "Oakland Co. Remonumentation P.S. #25854" in S'ly Side 15" Pine N 72° E 99.76'
PK Nail & Tag Stamped "Oakland Co. Remonumentation P.S. #25854" in E'ly Side Util. Pole N 05° W 60.23'
"1" Iron (Old Style) NE Corner 13 Mile & Franklin Fairway N 53° W 108.53'
1/2" Rebar NW Corner 13 Mile Rd. & Franklin Fairway N 64° W 161.99'

The selected location is accepted by the Contractor and is generally accepted by professional surveyors as the best available evidence of the position of the original corner.

Signed by Randy J. Kolehouse Date 5/20/97

Surveyor's Michigan License No. 25854

