

MAY 22 1997 COMMISSION

LAND CORNER RECORDATION CERTIFICATE Filing Requirement of Act 74, Mich. P.A. 1970

\$ 9.00 MISCELLANEOUS RECORDING \$ 2.00 REMONUMENTATION 18 DEC 96 1:38 P.M. RECEIPT# 358 PAID RECORDED - OAKLAND COUNTY LYNN D. ALLEN, CLERK/REGISTER OF DEEDS

For corners in

Form with fields for County (Oakland), Township (Farmington), Corner Code # (L-9), and numbered sections 1-5 for Public Land Survey, Property Controlling, Miscellaneous, Lot No., and Private Claims.

Compliance with ACT 345, P.A. 1990 APPROVED ON: 10-29-96 TS OAKLAND COUNTY REMONUMENTATION PEER GROUP COMMITTEE Register of Deeds Stamp & File Number

Grid table with columns A-L and rows 1-13, used for surveying reference.

I, Randy Kolehouse, in a field survey on September 2, 1996, do hereby certify that under requirements of P.A. 74 Michigan P.A. of 1970, the corner points mentioned in lines 1 and 2 above were in conformance with regulations and rules therefore as required in the current manual of survey instructions of the United States Department of the interior, Bureau of Land Management or by a decree of a Court of Law and/or that the corner points mentioned in lines 3, 4 and 5 above were in conformance with the rules of the Michigan Board of Land Surveyors or by a Decree of a Court of Law; established, re-established, monumented, re-monumented, recovered, found as expressed below:

NOTE: Not more than 4 corners, all in the same town and range, may be recorded on this certificate.

A. Description of original monument and accessories and/or subsequent restoration:

Table with columns for L-9, 1817, Wampler, G.L.O., and Set Post, listing monument details.

B. Description of corner evidence found and/or method applied in restoring or reestablishing corner:

L-9 Found a PK nail and tag 1' South of the C/L of 9 Mile Road running East and West per L.C.R.C. L. 10206 P. 762. This corner falls 1.05' East of the midpoint between K-9 and M-9. Found several irons along the north right-of-way line of 9 Mile Road (using Woodbine Sub. L. 58 P. 2) which check closely to 60' North of the Section line using the found PK nail. Also found several monuments and irons along the south right-of-way line of 9 Mile Road (using Irv Wilcove Estates Sub.) which check closely to 60.0 feet South of Section line using found PK nail. Accepted PK nail as corner. (See back for sketch of iron found and relationship to Section line.)

- L.C.R.C. L. 10206 P. 763
N 25° W 72.43' PK Nail S Side Guy Pole
S 79° W 196.42' PK Nail N Side DE Pole
S 33° W 38.59' PK Nail in E Side DE Pole
S 75° E 108.96' PD Nail NE Side Lt. Pole
N 49.93' Capped Iron Rod
S 53.88' Capped Iron Rod

Measures East 2632.92' to M-9 (G.L.O. = 2623.2') (Woodbine Sub. = 2635.4')
Measures West 2635.01' to K-9 (G.L.O. = 2623.2') (Tax Maps = 2634.±')

C. Description of monument for corner and accessories established to perpetuate locating the position of the corner:

L-9 Replaced the PK nail and tag with a 5/8" x 24" rebar with brass cap stamped "Oakland County Remonumentation P.S. #25854." Also set a monument box.


- Set PK Nail & Tag Stamped "Oakland Co. Remonumentation P.S. #25854" in E Side Guy Pole N 23° W 72.92'
Set PK Nail & Tag Stamped "Oakland Co. Remonumentation P.S. #25854" in N side DE Pole S 81° W 196.51'
Set PK Nail & Tag Stamped "Oakland Co. Remonumentation P.S. #25854" in W Side P. Pole S 36° W 39.14'
Set PK Nail & Tag Stamped "Oakland Co. Remonumentation P.S. #25854" in N Side Lt. Pole S 75° E 108.92'
Capped Iron N 49.95'
Capped Iron S 53.86'

The selected location is accepted by the Contractor and is generally accepted by professional surveyors as the best available evidence of the position of the original corner.

Signed by Randy J. Kolehouse EARTH TECH

Date 12/16/94

Surveyor's Michigan License No. 25854

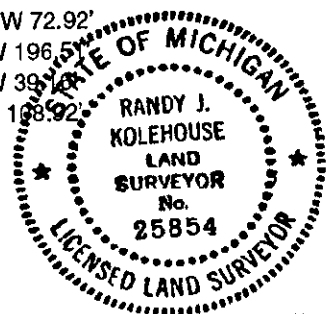

Handwritten note: 900 FILE 200