

SURVEY & REMONUMENTATION

JN -9 97 1 2 4 4 9 0

MAR 04 1998

LIBER 17277 PG 714

LAND CORNER RECORDATION CERTIFICATE
Filing Requirement of Act 74, Mich. P.A. 1970

Compliance with ACT 345, P.A. 1990

SECTION For corners in


Table with columns: County (Oakland), Township (Farmington), Corner Code # (M-4), and survey details (Public Land Survey, Property Controlling, etc.)

APPROVED ON: 4-16-97 JS
OAKLAND COUNTY REMONUMENTATION PEER GROUP COMMITTEE

\$ 7.00 MISCELLANEOUS RECORDING
\$ 2.00 REMONUMENTATION
9 JUN 97 12:24 P.M. RECEIPT# 94A
PAID RECORDED - OAKLAND COUNTY
LYNN D. ALLEN, CLERK/REGISTER OF DEEDS
Register of Deeds Stamp & File Number

- 4. Lot No. , Recorded Plat
5. Private Claims

I, Randy Kolehouse, in a field survey on April 9 19 97, do hereby certify that under requirements of P.A. 74 Michigan P.A. of 1970, the corner points mentioned in lines 1 and 2 above were in conformance with regulations and rules therefore as required in the current manual of survey instructions of the United States Department of the interior, Bureau of Land Management or by a decree of a Court of Law and/or that the corner points mentioned in lines 3, 4 and 5 above were in conformance with the rules of the Michigan Board of Land Surveyors or by a Decree of a Court of Law; established, re-established, monumented, re-monumented, recovered, found as expressed below:

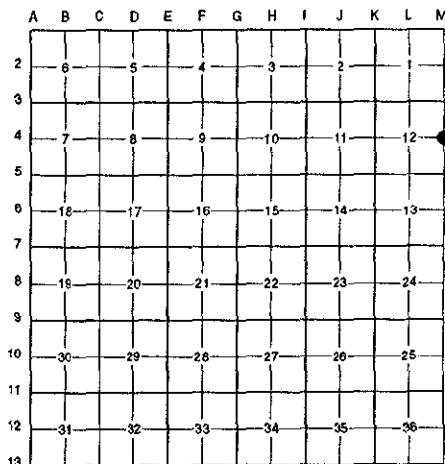

NOTE: Not more than 4 corners, all in the same town and range, may be recorded on this certificate.

A. Description of original monument and accessories and/or subsequent restoration:

Table with columns: Monument ID (M-4), Description (1817 Wampler, 1943 McAlpine, 1986 Donnelly, 1986 Donnelly, 1995 Dunn, N/A), G.L.O. Notes (Wood Creek Farms No. 1 L. 55 P. 33 A, L.C.R.C. L. 11062 P. 240, L.C.R.C. L. 15832 P. 178, O.C. Tax Maps), and Set Post (N/A, Iron Pipe in Mon. Box, Iron Pipe in Mon. Box, Iron Pipe in Mon. Box, N/A)

Records indicate this corner is not common with A-4, T1N, R10E.

B. Description of corner evidence found and/or method applied in restoring or reestablishing corner:

M-4 Found a 1/2" iron pipe in a monument box at the C/L of Inkster Road (bit.) running North and South and 20' South of the C/L of westbound Northwestern Highway (bit.) per L.C.R.C.'s L. 11062 P. 240 and L. 15832 P. 178. Checks closely distances as shown in recorded plat and survey of record.

- L.C.R.C. L. 11062 P. 240 (1986) Az 300° 83.18' Chisled "X" in South Rim of Michcon Gas M.H. Az 325° 52.20' Nail & MDOT Tag in SE Face of U. Pole Az 160° 116.74' PK Nail & RJD Flasher in NE Face of U. Pole
L.C.R.C. L. 15832 P. 178 (1995) N 88° W 11.41' PK Nail on North Face of Traffic Sign N 16° E 116.84' PK Nail on West Face of Power Tower N 60° E 48.79' South Bolt of Light Pole North 43.33' W 1/4 Corner Sec. 7, T1N, R10E, Iron Rod in Mon. Box

Measure North 2689.39' to M-3 (G.L.O. = 2640.0') (Supervisor's Plat of Wood Creek Farms = 2689.42')
Measure South 2651.60' to M-5 (G.L.O. = 2640.0') (Donnelly Survey (1986) = 2651.62')

C. Description of monument for corner and accessories established to perpetuate locating the position of the corner:

M-4 Replaced 1/2" iron with a 5/8" x 24" rebar with brass cap stamped "Oakland County Remonumentation P.S. #25854" in an existing monument box.

- PK Nail & Tag Stamped "Oakland Co. Remonumentation P.S. #25854" in E Side Util. Pole N 11° W 143.82'
PK Nail & Tag Stamped "Oakland Co. Remonumentation P.S. #25854" in W Side 46" Oak N 38° E 59.74'
PK Nail & Tag Stamped "Oakland Co. Remonumentation P.S. #25854" in S Side Signal Pole N 55° E 48.76'
PK Nail & Tag Stamped "Oakland Co. Remonumentation P.S. #25854" in NE Side Guy Pole S 23° E 116.71'
PK Nail & Tag Stamped "Oakland Co. Remonumentation P.S. #25854" in SE Side Util. Pole S 65° W 51.98'
Spike in Road (Possibly A-4, T1N, R10E) N 03° E 43.37'
"+ S Rim Michcon Gas M.H. N 57° W 83.19'

The selected location is accepted by the Contractor and is generally accepted by professional surveyors as the best available evidence of the position of the original corner.

Signed by Randy J. Kolehouse Date 5/28/97
EARTH TECH

Surveyor's Michigan License No. 25854

