

LIBR 17932 PG 774
LAND CORNER RECORDATION CERTIFICATE
 Filing Requirement of Act 74, Mich. P.A. 1970

For corners in

Oakland
(County)

Located In: Farmington Twp. Corner Code # _____

1. Public Land Survey

T 1-N R 9-E _____ D-9

T _____ R _____

T _____ R _____

T _____ R _____

2. Property Controlling in Section

S _____ T _____ R _____

S _____ T _____ R _____

3. Miscellaneous Property in Sec.

S _____ T _____ R _____

S _____ T _____ R _____

**SURVEY &
 REMONUMENTATION**

MAR 21 2000

SECTION

\$ 7.00 MISCELLANEOUS RECORDING
 \$ 2.00 REMONUMENTATION
 2 JAN 98 9:02 A.M. RECEIPT# 12A
 PAID RECORDED - OAKLAND COUNTY
 LYNN D. ALLEN, CLERK REGISTER OF DEEDS
ACT 345, P.A. 1990

APPROVED ON: 4-28-97 IS
 OAKLAND COUNTY REMONUMENTATION
 PEER GROUP COMMITTEE
 Register of Deeds Stamp & File Number

4. Lot No. _____, Recorded Plat _____

5. Private Claims _____

I, John N. Redash, in a field survey on March 6, 1997 do hereby state that under requirements of P.A. 74, Michigan P.A. of 1970, the corner points mentioned in lines 1 and 2 above were in conformance with regulations and rules therefore as required in the current manual of survey instructions of the United States Department of the Interior, Bureau of Land Management or by a decree of a Court of Law and /or that the corner points mentioned in lines 3, 4 and 5 above were in conformance with the rules of the Michigan Board of Land Surveyors or by a Decree of a Court of Law; established, re-established, monumented, recovered, found as expressed below:

NOTE: Not more than 2 corners, all in the same town and range, may be recorded on this certificate.

1	A	B	C	D	E	F	G	H	I	J	K	L
2	6		5		4		3		2		1	
3												
4	7		8		9		10		11		12	
5												
6	18		17		16		15		14		13	
7												
8	19		20		21		22		23		24	
9												
10	30		29		28		27		26		25	
11												
12	31		32		33		34		35		36	
13												

A. Description of original monument and accessories and/or subsequent restoration:

1817	Set post	S. Carpenter	n/a	G.L.O. Notes
1978	Set P.K. nail	T. Cantrell	#5782	L.C.R.C L7191 p.509, 510
1986	Found P.K. nail	D. Sandomierski	#24616	L.C.R.C. L9443 p.172

B. Description of corner evidence found and/or method applied in restoring or reestablishing corner:


A 1/2" iron in monument box in North edge of metal of center lane Grand River currently occupies this corner. Current measurements match 3 ties each from L.C.R.C. L 7191, P509, 510 and L9443, P172. Field measurements were made between the following corners

C-9 to D-9	D-9 to E-9
2622.34 meas.	2637.99 meas.
2617.40 Rec. G.L.O.	2617.40 Rec. G.L.O.
2623.48 Tax maps	2640.35 Rec. Plats L138 P.37
	2637.49 Unrecorded Survey

C. Description of monument for corner and accessories established to perpetuate locating the position of the corner:

I placed a 2" diameter brass cap stamped "Oakland County Remonumentation PS 37281" on the existing 1 1/2" iron in monument box
 Witness ties are as follows:

S 10° W.,	38.95'	Centerline top nut fire hydrant
N 68° W.,	121.18'	Centerline top nut fire hydrant
S 40° W.,	124.52'	Northwest corner building
S 40° E.,	139.61'	Northeast corner building
N 5° W.,	50.27'	Southwest corner brick wall

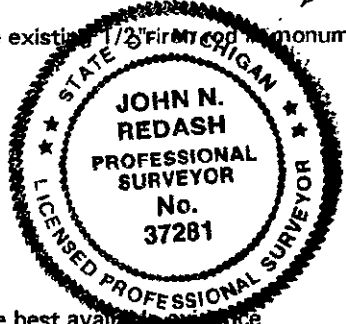

The selected location is accepted by me and generally accepted by Professional Surveyors as the best available evidence of the position of the original corner.

Signed by John N. Redash
 Surveyor's Michigan License No. 37281

Date April 24, 1997