

SURVEY & REMONUMENTATION

LIBER 19843PG625

MAY 24 2000

LAND CORNER RECORDATION CERTIFICATE
Filing Requirement of Act 74, Mich. P.A. 1970

131634

For corners in SECTION

LIBER 19843 PAGE 625
\$9.00 MISC RECORDING
\$2.00 REMONUMENTATION
04/16/1999 08:59:10 A.M. RECEIPT# 19968
PAID RECORDED - OAKLAND COUNTY
G. WILLIAM CADDELL, CLERK/REGISTER OF DEEDS

Oakland (county)	Located In: Southfield Township	Corner Code # A-9
1. Public Land Survey	T1N R10E	A-9
	T R	
	T R	
	T R	
2. Property Controlling in Section	S T R	
	S T R	
3. Miscellaneous Property in Sec.	S T R	
	S T R	

Compliance with ACT 345, P.A. 1990
APPROVED ON: 3-03-99 JS
OAKLAND COUNTY REMONUMENTATION PEER GROUP COMMITTEE
Register of Deeds Stamp & File Number

4. Lot No. _____, Recorded Plat _____

5. Private Claims _____

I, Joseph C. Kapelczak, in a field survey on January 24, 1998, do hereby certify that under requirements of P.A. 74, Michigan P.A. of 1970, the corner points mentioned in lines 1 and 2 above were in conformance with regulations and rules therefore as required in the current manual of survey instructions of the United States Department of the Interior, Bureau of Land Management or by a decree of a Court of Law and/or that the corner points mentioned in lines 3, 4 and 5 above were in conformance with the rules of the Michigan Board of Land Surveyors or by a Decree of a Court of Law; established, re-established, monumented, re-monumented, recovered, found as expressed below:

A	B	C	D	E	F	G	H	I	J	K	L	M
2	6	5	4	3	2	1						
3												
4	7	8	9	10	11	12						
5												
6	16	17	18	15	14	13						
7												
8	19	20	21	22	23	24						
9												
10	30	29	28	27	26	25						
11												
12	31	32	33	34	35	36						
13												

NOTE: Not more than 4 corners, all in the same town and range, may be recorded on this certificate.

A. Description of original monument and accessories and/or subsequent restoration:

Set post 1816 G.L.O. Survey.
There is one LCRC recorded at Oakland County for the remonumentation of Farmington Township.

B. Description of corner evidence found and/or method applied in restoring or reestablishing corner:

Recovered an Oakland County Remonumentation capped iron in a monument box at the intersection of Ten Mile and Inkster Roads. This corner will not agree with irons found along the east Southfield Road R.O.W. in Parcels 19-351-023 and 022 but it will agree with monumentation found on the north side of Ten Mile Road for the first 1/4 mile east of the corner. In reviewing the existing monumentation along the north side of Ten Mile it clearly indicates that there was a deflection at the southeast corner of the southwest 1/4 of southwest 1/4 of Section 19. Therefore, in my conclusions of the evidence, A-9 Southfield Township is common to M-9 of Farmington Township.

Recovered Witnesses:

- N 46°W 43.98' nail and washer #10705 southwest side utility pole.
- S 28°E 79.29' nail and tag #12022 northeast side utility pole.
- S 28°E 79.16' nail and tag #10705 southwest side utility pole.
- S 46°W 55.31' nail and tag #10705 southeast side utility pole.
- N 39°E 53.74' nail and tag #10705 southeast side utility pole.


JP
R

C. Description of monument for corner and accessories established to perpetuate locating the position of the corner:

Found Oakland County Remonumentation Brass Cap in monument box.

Set Witnesses:

- N 39°E 53.74' PK nail and OCRT #24598 southeast side utility pole.
- S 46°W 55.31' PK nail with OCRT #24598 southeast side utility pole.
- S 28°E 79.16' PK nail with OCRT #24598 southwest side utility pole.
- N 46°W 43.98' PK nail with OCRT #24598 southwest side utility pole.

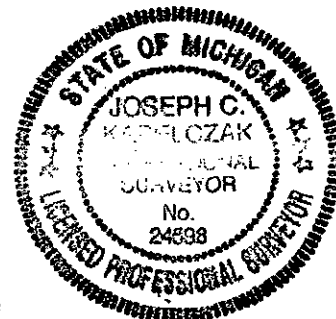

Signed by Joseph C. Kapelczak

Date 2/5/99

Surveyor's Michigan License No. 24598