

SURVEY & REMONUMENTATION

MAY 24 2000

LIBER 19843 POC 23

LAND CORNER RECORDATION CERTIFICATE  
Filing Requirement of Act 74, Mich. P.A. 1970

131633

SECTION

For corners in

LIBER 19843 PAGE 623  
\$9.00 MISC RECORDING  
\$2.00 REMONUMENTATION  
04/16/1999 08:59:08 A.M. RECEIPT# 1996A  
PAID RECORDED - OAKLAND COUNTY  
G. WILLIAM CADDELL, CLERK/REGISTER OF DEEDS

Oakland  
(county)

Located In: Corner Code #  
Southfield Township

1. Public Land Survey	T1N	R10E	A-10
	T	R	
	T	R	
	T	R	
2. Property Controlling in Section	S	T	R
	S	T	R
3. Miscellaneous Property in Sec.	S	T	R
	S	T	R

Compliance with  
ACT 345, P.A. 1990

APPROVED ON: 3-03-99 JS  
OAKLAND COUNTY REMONUMENTATION  
PEER GROUP COMMITTEE

Register of Deeds Stamp & File Number

4. Lot No. \_\_\_\_\_, Recorded Plat \_\_\_\_\_

5. Private Claims \_\_\_\_\_

I, Joseph C. Kapelczak, in a field survey on January 30, 1998, do hereby certify that under requirements of P.A. 74, Michigan P.A. of 1970, the corner points mentioned in lines 1 and 2 above were in conformance with regulations and rules therefore as required in the current manual of survey instructions of the United States Department of the Interior, Bureau of Land Management or by a decree of a Court of Law and/or that the corner points mentioned in lines 3, 4 and 5 above were in conformance with the rules of the Michigan Board of Land Surveyors or by a Decree of a Court of Law; established, re-established, monumented, re-monumented, recovered, found as expressed below:

A	B	C	D	E	F	G	H	I	J	K	L	M
2	6	5	4	3	2	1						
3												
4	7	8	9	10	11	12						
5												
6	16	17	18	15	14	13						
7												
8	19	20	21	22	23	24						
9												
10	30	29	28	27	26	25						
11												
12	31	32	33	34	35	36						
13												

NOTE: Not more than 4 corners, all in the same town and range, may be recorded on this certificate.

A. Description of original monument and accessories and/or subsequent restoration:

Set post in 1816 G.L.O. Survey  
There are no LCRC's recorded at Oakland County.

B. Description of corner evidence found and/or method applied in restoring or reestablishing corner:


Recovered an Oakland County Remonumentation capped iron in monument box at this location. This corner was validated with monumentation recovered on the west line of the RAVINE'S SUBDIVISION. This section corner is a common corner to M-10 of T.1N., R. 9E., Farmington Township.

C. Description of monument for corner and accessories established to perpetuate locating the position of the corner:

Recovered Oakland County Remonumentation Brass Cap.

Recovered Witnesses:

- S 38W 42.71' PK nail with OCR Tag southeast side twin 8" Elm.
- N 23W 54.84' PK nail with OCR Tag northeast side 20" Maple.
- N 44E 45.75' PK nail with OCR Tag northwest side 28" Maple.
- S 42E 62.61' PK nail with OCR Tag south side 12" Pine.

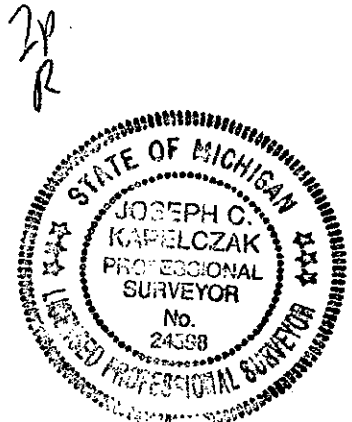

Signed by Joseph C. Kapelczak

Date 2/5/99

Surveyor's Michigan License No. 24598

# 786 01