

MICHIGAN
DEPARTMENT OF CONSERVATION
FORESTRY DIVISION

LAND CORNER RECORD

5

T. 2 N.R. 7 E


Oakland COUNTY

DESCRIPTION OF CORNER E 1/4 post Section 13

CORNER MONUMENT 1" iron pipe with brass cap

DATE MONUMENT PLACED AND WITNESSED August 17, 1961

WITNESSES TO CORNER..... Guard Post w/stake N 17°30' E 63.81'

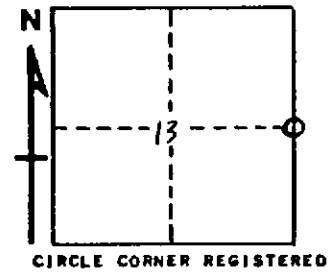

" " " " N 16°16' E 63.85'

20' CMP under Wixon Rd (North CMP) S 10°45' E 126.15' 2 chiseled notches in end and a diagonal mark

" " " " " " " " " " " "

AND S 11°30' W 126.45' "

DESCRIPTION IN DETAIL AS TO HOW CORNER WAS LOCATED AND IDENTIFIED OR RESTORED.

The SE and NE corners of section 13 were recovered from witnesses furnished by the Oakland County Road Commission, and a line was run between these corners and noted approximately 10' of Road fill at original 1/4 post location. The original G.H.O. 1/4 post was set at 40.00 chains and mile set at 80.00 chains. The new post was set at the mid point of the line between the SE and NE corners. It is assumed that the new 1/4 post is over the original location.

SURVEYOR'S SEAL

M-6

SIGNED _____ DATE _____

REGISTERED LAND SURVEYOR