

SURVEY & REMONUMENTATION

MAY 24 2000

SECTION

LIBER 21143 047

58652

LAND CORNER RECORDATION CERTIFICATE
 Filing Requirement of Act 74, Mich. P.A. 1970

LIBER 21143 PAGE 47
 \$9.00 MISC RECORDING
 \$2.00 REMONUMENTATION
 02/28/2000 01:52:04 P.M. RECEIPT# 1629
 PAID RECORDED - OAKLAND COUNTY
 B. WILLIAM CADDELL, CLERK/REGISTER OF D

For corners in

Oakland

(County)

Located In:

Corner Code #

- | | | | | | |
|------------------------------------|---|----|---|----|------|
| 1. Public Land Survey | T | 2N | R | 7E | A-13 |
| | T | | R | | |
| | T | | R | | |
| | T | | R | | |
| 2. Property Controlling in Section | S | | T | R | |
| | S | | T | R | |
| 3. Miscellaneous Property in Sec. | S | | T | R | |
| | S | | T | R | |

Compliance with ACT 345, P.A. 1990
 APPROVED ON: 12-7-99 J/L
 OAKLAND COUNTY REMONUMENTATION PEER GROUP COMMITTEE

Register of Deeds Stamp & File Number

4. Lot No. _____, Recorded Plat _____
 5. Private Claims _____

I, Grant J. Ward, R.L.S., in a field survey on October 12, 1999 do hereby state that under requirements of P.A. 74, Michigan P.A. of 1970, the corner points mentioned in lines 1 and 2 above were in conformance with regulations and rules therefore as required in the current manual of survey instructions of the United States Department of the Interior, Bureau of Land Management or by a decree of a Court of Law and /or that the corner points mentioned in lines 3, 4 and 5 above were in conformance with the rules of the Michigan Board of Land Surveyors or by a Decree of a Court of Law; established, re-established, monumented, recovered, found as expressed below:

NOTE: Not more than 2 corners, all in the same town and range, may be recorded on this certificate.

| | | | | | | | | | | | | |
|----|----|---|----|---|----|---|----|---|----|---|----|---|
| | A | B | C | D | E | F | G | H | I | J | K | L |
| 1 | | | | | | | | | | | | |
| 2 | 6 | | 5 | | 4 | | 3 | | 2 | | 1 | |
| 3 | | | | | | | | | | | | |
| 4 | 7 | | 8 | | 9 | | 10 | | 11 | | 12 | |
| 5 | | | | | | | | | | | | |
| 6 | 18 | | 17 | | 16 | | 15 | | 14 | | 13 | |
| 7 | | | | | | | | | | | | |
| 8 | 19 | | 20 | | 21 | | 22 | | 23 | | 24 | |
| 9 | | | | | | | | | | | | |
| 10 | 30 | | 29 | | 28 | | 27 | | 26 | | 25 | |
| 11 | | | | | | | | | | | | |
| 12 | 31 | | 32 | | 33 | | 34 | | 35 | | 36 | |
| 13 | | | | | | | | | | | | |

A. Description of original monument and accessories and/or subsequent restoration:
 A-13 Post, per G.L.O. Notes.


B. Description of corner evidence found and/or method applied in restoring or reestablishing corner:
 A-13 Southwest Corner of Section 31, T. 2 N., R. 7 E. Found Monument and Remonumentation Cap #29238.

Previously unrecorded in Oakland County.

This corner location is accepted by the contractor and is generally accepted by professional surveyors as the best available evidence of the position of the original corner.

C. Description of monument for corner and accessories established to perpetuate locating the position of the corner:

- A-13 Found Monument & Remonumentation Cap #29238.
- N 45° E 33.90' Set 60d Nail & Remonumentation Disc in Southeast face of 24" Walnut.
- East 32.88' Set 60d Nail & Remonumentation Disc in South face of 14" Walnut.
- S 45° E 39.40' Set 60d Nail & Remonumentation Disc in North root of 50" Walnut.
- N 30° W 43.05' Set 60d Nail & Remonumentation Disc in Northeast face of Twin 16" Oak.
- North 356.96' Found Iron Rod & Remonumentation Cap #25826

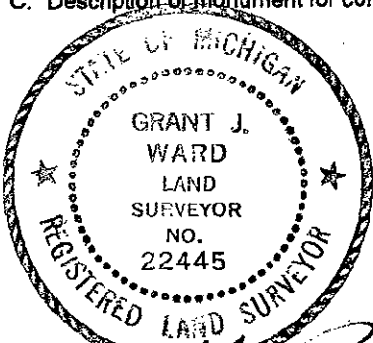

Signed by _____
 Surveyor's Michigan License No. 22445

Date October 22, 1999