

Milford
LAND CORNER RECORDATION CERTIFICATE 25848
 Filing Requirement of Act 74, Mich. P.A. 1970

For corners in
Oakland
 (County)

Located in: Corner Code #

LIBER 21028 PAGE 469
 \$9.00 MISC RECORDING
 \$2.00 REMONUMENTATION
 01/27/2000 08:21:22 A.M. RECEIPT# 6667
 PAID RECORDED - OAKLAND COUNTY
 G. WILLIAM CADDELL, CLERK/REGISTER OF DEED

Compliance with
 ACT 345, P.A. 1990

APPROVED ON: 8-18-99 JK
 OAKLAND COUNTY REMONUMENTATION
 PEER GROUP COMMITTEE
 Register of Deeds Stamp & File Num

1. Public Land Survey

T 2N R 7E B-7

T R

T R

T R

2. Property Controlling
 in Section

S T R SURVEY &
 S T R REMONUMENTATION

3. Miscellaneous
 Property in Sec.

S T R
 S T R MAR 21 2000

4. Lot No. _____, Recorded Plat _____ SECTION _____
 5. Private Claims _____

I, Grant J. Ward, R.L.S., in a field survey on March 17, 1999 do hereby state that under requirements of P.A. 74, Michigan P.A. of 1970, the corner points mentioned in lines 1 and 2 above were in conformance with regulations and rules therefore as required in the current manual of survey instructions of the United States Department of the Interior, Bureau of Land Management or by a decree of a Court of Law and/or that the corner points mentioned in lines 3, 4 and 5 above were in conformance with the rules of the Michigan Board of Land Surveyors or by a Decree of a Court of Law; established, re-established, monumented, recovered, found as expressed below:

NOTE: Not more than 2 corners, all in the same town and range, may be recorded on this certificate.

1	A	B	C	D	E	F	G	H	I	J	K
2		6		5		4		3		2	
3											
4		7		8		9		10		11	
5											
6		18		17		16		15		14	
7											
8		19		20		21		22		23	
9											
10		30		29		28		27		26	
11											
12		31		32		33		34		35	
13											

A. Description of original monument and accessories and/or subsequent restoration:

B-7 Post, per G.L.O. Notes.

B. Description of corner evidence found and/or method applied in restoring or reestablishing corner:

B-7 North 1/4 Corner of Section 19, T. 2 N., R. 7 E. Found 1/2" Iron Pipe on Monument Box in the Centerline of Stobart Road.


Previously unrecorded.

(n) Indicates the number of references that confirms this corner by dimensional tie.

This corner location is accepted by the contractor and is generally accepted by professional surveyors as the best available evidence of the position of the original corner.

C. Description of monument for corner and accessories established to perpetuate locating the position of the corner:

- B-7 Set 5/8" Rod and Remonumentation Cap in existing Monument Box.
- S 40° E 44.59' Set 60d Nail & Remonumentation Disc in Northeast face of 18" Oak.
- S 30° W 37.18' Set 60d Nail & Remonumentation Disc in Northwest face of 18" Oak.
- S 40° W 34.48' Set 60d Nail & Remonumentation Disc in Northwest face of 10" Oak.
- S 55° W 54.33' Set 60d Nail & Remonumentation Disc in Southeast face of 10" Oak.

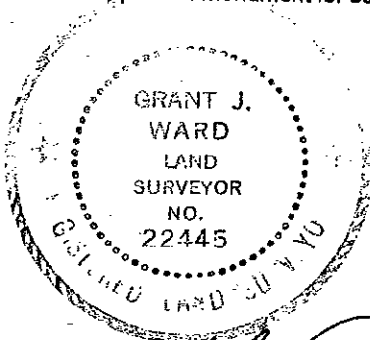

Signed by [Signature]
 Surveyor's Michigan License No. 22445

Date July 12, 1999

JULY 20, 1999

Corner Code: B-7

DOSSIER FOR: THE SOUTH 1/4 CORNER OF SECTION 18, MILFORD TOWNSHIP,
T 2 N, R 7 E, OAKLAND COUNTY, MICHIGAN. Prepared under contract with the
County of Oakland Under Act 345 of the Public Acts of 1990.

HISTORY:

This Corner has been accepted and used since before 1954, as evidenced by an un-
recorded survey by Warner and Warner for General Motors Corporation. This Cor-
ner has not been previously recorded.

COLLATERAL EVIDENCE:

We found an iron pipe in an existing monument box and set a 5/8" iron rod and
remonumentation cap in its place. This Corner lies in the Centerline of Stobart
Road. There is no evidence of occupation running North or South from the Cor-
ner. We measured 0.14 feet and 0.06 feet less than the recorded distances to the
Southwest and the Southeast Corners of Section 18 respectively. We searched at
least 50 feet in each direction for other stakes and found none that might repre-
sent the Corner.

SURVEYOR'S RECOMMENDATIONS:

This corner location is accepted by the Contractor and is generally accepted by Profes-
sional Surveyors as the best available evidence of the position of the original Cor-
ner. Therefore, I recommend that the Peer Review Group accept this Corner as
monumented, with the references as shown on the enclosed form prepared accord-
ing to Act 74 of the Public Acts of 1970.

Grant J. Ward, R.L.S.
License No. 22445

**SURVEY &
REMONUMENTATION**

MAR 21 2000

SECTION