

SURVEY & REMONUMENTATION

MAY 24 2000

LIBER 21143 PAGE 55

58656

LAND CORNER RECORDATION CERTIFICATE
 Filing Requirement of Act 74, Mich. P.A. 1970

LIBER 21143 PAGE 55
 \$9.50 MISC RECORDING
 02/28/2000 01:52:10 P.M. RECEIPT# 16297
 PAID RECORDED - OAKLAND COUNTY
 G. WILLIAM CARDELL, CLERK/REGISTER OF DEEDS

For corners in

Oakland

(County)

Located In:

Corner Code #

1. Public Land Survey

T2N R 7E C-8

T R

T R

T R

2. Property Controlling in Section

S T R

S T R

3. Miscellaneous Property in Sec.

S T R

S T R

Compliance with ACT 345, P.A. 1990

APPROVED ON: 8-31-99 571
 OAKLAND COUNTY REMONUMENTATION FEE GROUP COMMITTEE

Register of Deeds Stamp & File Number

4. Lot No. _____, Recorded Plat _____
 5. Private Claims _____

I, Grant J. Ward, R.L.S., in a field survey on December 4, 1998 do hereby state that under requirements of P.A. 74, Michigan P.A. of 1970, the corner points mentioned in lines 1 and 2 above were in conformance with regulations and rules therefore as required in the current manual of survey instructions of the United States Department of the Interior, Bureau of Land Management or by a decree of a Court of Law and/or that the corner points mentioned in lines 3, 4 and 5 above were in conformance with the rules of the Michigan Board of Land Surveyors or by a Decree of a Court of Law, established, re-established, monumented, recovered, found as expressed below:

NOTE: Not more than 2 corners, all in the same town and range, may be recorded on this certificate.

A	B	C	D	E	F	G	H	I	J	K	L	M
1												
2	6		5		4		3		2		1	
3												
4	7		8		9		10		11		12	
5												
6	18		17		16		15		14		13	
7												
8	19		20		21		22		23		24	
9												
10	30		29		28		27		26		25	
11												
12	31		32		33		34		35		36	
13												

A. Description of original monument and accessories and/or subsequent restoration:

C-8 Post, per G.L.O. Notes.

B. Description of corner evidence found and/or method applied in restoring or reestablishing corner:

C-8 West 1/4 Corner of Section 20, T. 2 N., R. 7 E. Found Concrete Monument.


Previously Recorded in L. 10930 P. 206 (3), L. 11025 P. 269 (3) and L. 11604 P. 650 (3) of Oakland County Records.

(n) Indicates the number of references that confirms this corner by dimensional tie.

This corner location is accepted by the contractor and is generally accepted by professional surveyors as the best available evidence of the position of the original corner.

C. Description of monument for corner and accessories established to perpetuate locating the position of the corner:

- C-8 Set Monument and Brass Remonumentation Cap.
- East 9.96' Set 60d Nail & Remonumentation Disc in Northwest face of Power Pole.
- S 55° W 47.51' Set 60d Nail & Remonumentation Disc in East face of 12" Cherry.
- West 29.79' Set 60d Nail & Remonumentation Disc in North face of 16" Cherry.
- N 15° W 39.76' Set 60d Nail & Remonumentation Disc in Southwest face of 12" Oak.
- West 33.75' Found iron pipe and cap #19005
- West 10.77' Found 1/2" iron rod
- West 10.28' Found iron rod and cap #15066
- S 68° W 0.93' Found iron rod

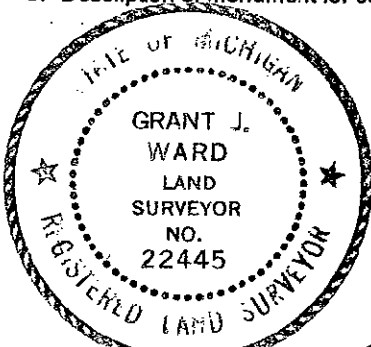

Signed by _____
 Surveyor's Michigan License No. 22445

Date November 11, 1999