

LAND CORNER RECORDATION CERTIFICATE

25860

Filing Requirement of Act 74, Mich. P.A. 1970

21028 PAGE 493  
\$1.00 MISC RECORDING  
\$2.00 REMONUMENTATION  
01/27/2000 08:21:22 A.M. RECEIPT# 6667  
PAID RECORDED - OAKLAND COUNTY  
G. WILLIAM CARDELL, CLERK/REGISTER OF DEEDS

For corners in

Oakland

(County)

Located In:

Corner Code #

1. Public Land Survey

T 2N R 7E

C-11

T R

T R

T R

T R

2. Property Controlling in Section

S T

T R

S T

T R

3. Miscellaneous Property in Sec.

S T

T R

S T

T R

SURVEY & REMONUMENTATION

MAR 21 2000

Compliance with ACT 345, P.A. 1990

APPROVED ON: 8-31-99 JK  
OAKLAND COUNTY REMONUMENTATION PEER GROUP COMMITTEE

Register of Deeds Stamp & File Number

SECTION

4. Lot No. Recorded Plat

5. Private Claims

	A	B	C	D	E	F	G	H	I	J	K	L
1												
2		6		5		4		3		2		1
3												
4		7		8		9		10		11		12
5												
6		18		17		16		15		14		13
7												
8		19		20		21		22		23		24
9												
10		30		29		28		27		26		25
11												
12		31		32		33		34		35		36
13												

I, Grant J. Ward, R.L.S., in a field survey on June 29, 1999 do hereby state that under requirements of P.A. 74, Michigan P.A. of 1970, the corner points mentioned in lines 1 and 2 above were in conformance with regulations and rules therefore as required in the current manual of survey instructions of the United States Department of the Interior, Bureau of Land Management or by a decree of a Court of Law and /or that the corner points mentioned in lines 3, 4 and 5 above were in conformance with the rules of the Michigan Board of Land Surveyors or by a Decree of a Court of Law; established, re-established, monumented, recovered, found as expressed below:

NOTE: Not more than 2 corners, all in the same town and range, may be recorded on this certificate.

A. Description of original monument and accessories and/or subsequent restoration:

C-11 Post, per G.L.O. Notes.

B. Description of corner evidence found and/or method applied in restoring or reestablishing corner:


C-11 Northeast Corner of Section 31, T. 2 N., R. 7 E.

Previously Unrecorded.

This corner location is accepted by the contractor and is generally accepted by professional surveyors as the best available evidence of the position of the original corner.

C. Description of monument for corner and accessories established to perpetuate locating the position of the corner:

- C-11 Set Monument and Remonumentation Cap.
- N 20° E 31.23' Set 60d Nail & Remonumentation Disc in West face of 16" Poplar.
- S 10° E 14.23' Set 60d Nail & Remonumentation Disc in West face of 12" Sycamore.
- S 45° W 29.83' Set 60d Nail & Remonumentation Disc in West face of 18" Oak.
- N 40° W 11.32' Set 60d Nail & Remonumentation Disc in South face of 8" Sycamore.

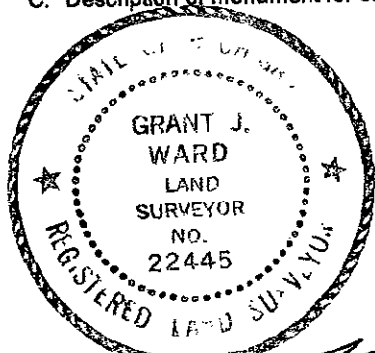

Signed by

[Signature]

Date July 12, 1999

Surveyor's Michigan License No. 22445

AUGUST 29, 1999

Corner Code: C-11

DOSSIER FOR: THE SOUTHWEST CORNER OF SECTION 29, MILFORD TOWNSHIP, T 2 N, R 7 E, OAKLAND COUNTY, MICHIGAN. Prepared under contract with the County of Oakland Under Act 345 of the Public Acts of 1990.

**HISTORY:**

The Corner we set is based on coordinates taken from an unrecorded survey for the Huron-Clinton Metropolitan Authority (HCMA) in 1945. This Corner has not been recorded.

**COLLATERAL EVIDENCE:**

We set a concrete monument and remonumentation cap at the coordinates shown on the old survey. We measured 0.89 feet less than the recorded distance to the East 1/4 Corner of Section 30 and the same distances to the other three adjacent Government Corners as was recorded. We searched at least 50 feet in each direction for other stakes and found none that might represent the Corner.

**SURVEYOR'S RECOMMENDATIONS:**

This corner location is accepted by the Contractor and is generally accepted by Professional Surveyors as the best available evidence of the position of the original Corner. Therefore, I recommend that the Peer Review Group accept this Corner as monumented, with the references as shown on the enclosed form prepared according to Act 74 of the Public Acts of 1970.

---

Grant J. Ward, R.L.S.  
License No. 22445

SURVEY &  
REMONUMENTATION

MAR 21 2000

SECTION