

SURVEY & REMONUMENTATION

MAY 24 2000
P. J. Mitter
SECTION

LIBER 21143 057

LAND CORNER RECORDATION CERTIFICATE
 Filing Requirement of Act 74, Mich. P.A. 1970

58657

For corners in

| | | |
|------------------------------------|-------------|---------------|
| Oakland (County) | Located In: | Corner Code # |
| 1. Public Land Survey | T2N R 7E | C-13 |
| | T R | |
| | T R | |
| | T R | |
| 2. Property Controlling in Section | S T R | |
| | S T R | |
| 3. Miscellaneous Property in Sec. | S T R | |
| | S T R | |

LIBER 21143 PAGE 57
 \$9.00 MISC RECORDING
 \$2.00 REMONUMENTATION
 02/28/2000 01:52:10 P.M. RECEIPT# 16297
 PAID RECORDED - OAKLAND COUNTY
 G. WILLIAM CADDELL, CLERK/REGISTER OF DEEDS

Compliance with
 ACT 74, P.A. 1990

APPROVED ON: 12-7-99 JIL
 OAKLAND COUNTY REMONUMENTATION
 PEER GROUP COMMITTEE

Register of Deeds Stamp & File Number

4. Lot No. _____, Recorded Plat _____
 5. Private Claims _____

I, Grant J. Ward, R.L.S., in a field survey on October 12, 1999 do hereby state that under requirements of P.A. 74, Michigan P.A. of 1970, the corner points mentioned in lines 1 and 2 above were in conformance with regulations and rules therefore as required in the current manual of survey instructions of the United States Department of the Interior, Bureau of Land Management or by a decree of a Court of Law and /or that the corner points mentioned in lines 3, 4 and 5 above were in conformance with the rules of the Michigan Board of Land Surveyors or by a Decree of a Court of Law; established, re-established, monumented, recovered, found as expressed below:

| A | B | C | D | E | F | G | H | I | J | K | L | M |
|----|----|---|----|---|----|---|----|---|----|---|----|---|
| 1 | | | | | | | | | | | | |
| 2 | 6 | | 5 | | 4 | | 3 | | 2 | | 1 | |
| 3 | | | | | | | | | | | | |
| 4 | 7 | | 8 | | 9 | | 10 | | 11 | | 12 | |
| 5 | | | | | | | | | | | | |
| 6 | 18 | | 17 | | 16 | | 15 | | 14 | | 13 | |
| 7 | | | | | | | | | | | | |
| 8 | 19 | | 20 | | 21 | | 22 | | 23 | | 24 | |
| 9 | | | | | | | | | | | | |
| 10 | 30 | | 29 | | 28 | | 27 | | 26 | | 25 | |
| 11 | | | | | | | | | | | | |
| 12 | 31 | | 32 | | 33 | | 34 | | 35 | | 36 | |
| 13 | | | | | | | | | | | | |

NOTE: Not more than 2 corners, all in the same town and range, may be recorded on this certificate.

A. Description of original monument and accessories and/or subsequent restoration:
 C-13 Post, per G.L.O. Notes.


B. Description of corner evidence found and/or method applied in restoring or reestablishing corner:
 C-13 Southeast Corner of Section 31, T. 2 N., R. 7 E.

Previously unrecorded.

This corner location is accepted by the contractor and is generally accepted by professional surveyors as the best available evidence of the position of the original corner.

C. Description of monument for corner and accessories established to perpetuate locating the position of the corner:

- C-13 Capped Existing Monument 1108.63' East of the Corner on the Township Line.
- S 85° E 20.47' Set 60d Nail & Remonumentation Disc in North face of 6" Cherry.
- S 40° E 42.72' Set 60d Nail & Remonumentation Disc in East face of 14" Cherry.
- S 85° W 40.78' Set 60d Nail & Remonumentation Disc in North face of 20" Oak.
- N 05° W 25.67' Set 60d Nail & Remonumentation Disc in West face of 8" Cherry.
- East 66.03' Found Monument.

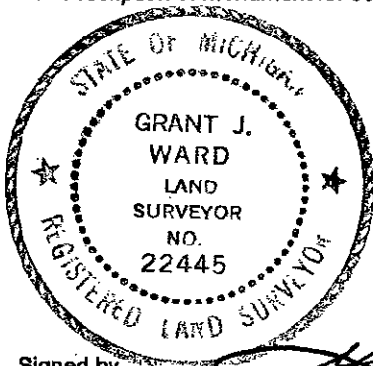

Signed by *Grant J. Ward*
 Surveyor's Michigan License No. 22445

Date October 22, 1999