LAND CORNER RECORDATION CERTIFICATER 21028 PAGE

25862

| | Filir | ng Requirement of Act /4, Mich. P.A. | PC" NO KEUNUNENIHITAN |
|-------------------------|---------------|--------------------------------------|---|
| For corners in | , | | 01/27/2000 08:21:22 A.M. RECEIPT# 6667 PAID RECORDED - OAKLAND COUNTY |
| Oakland | Located in: | Corner Code # | G. WILLIAM CADDELL, CLERK/REGISTER OF DEED |
| (County) | | · | |
| 1. Public Land Survey | T <u>2N</u> R | 7E <u>D-1</u> | |
| | <u>TR</u> | | · |
| | TR | | Compliance with ACT 345, P.A. 1990 |
| 2. Property Controlling | s TR | REMONUMENTATION | APPROVED ON: 8-31-59 JL |

MAR 21 2000

SECTION _, Recorded Plat _ 5. Private Claims


in Section

3. Miscellaneous

Property in Sec.

I, Grant J. Ward, R.L.S. , in a field survey on <u>August 15, 1999</u> do hereby state that under requirements of P.A. 74, Michigan P.A. of 1970, the corner points mentioned in lines 1 and 2 above were in conformance with regulations and rules therefore as required in the current manual of survey instructions of the United States Department of the Interior, Bureau of Land Management or by a decree of a Court of Law and /or that the corner points mentioned in lines 3, 4 and 5 above were in conformance with the rules of the Michigan Board of Land Surveyors or by a Decree of a Court of Law; established, re-established, monumented, recovered, found as expressed below:

NOTE: Not more than 2 comers, all in the same town and range, may be recorded on this certificate.

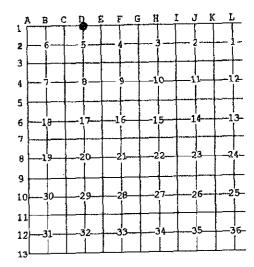

OAKLAND COUNTY REMONUMENTATION

PEER GROUP COMMITTEE

Register of Deeds Stamp & File Number

A. Description of original monument and accessories and/or subsequent restoration: Post, per G.L.O. Notes. D-1


Description of corner evidence found and/or method applied in restoring or reestablishing corner: North 1/4 Corner of Section 5, T. 2 N., R. 7 E. Found 1/2" Iron Rod.

Previously Recorded in L. 18918 P. 051 (5) of Oakland County Records.

(n) Indicates the number of references that confirms this corner by dimensional tie.

This corner location of a corner, although not established by an original government survey, is accepted as the best available evidence of the position of the corner.

C. Description of monument for corner and accessories established to perpetuate locating the position of the corner.

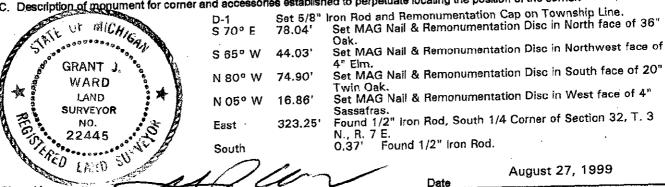

Signed by 22445 Surveyor's Michigan License No.

AUGUST 24,1999

Corner Code: **D-1**

DOSSIER FOR: THE NORTH 1/4 CORNER OF SECTION 5, MILFORD TOWNSHIP, T 2 N, R 7 E, OAKLAND COUNTY, MICHIGAN. Prepared under contract with the County of Oakland Under Act 345 of the Public Acts of 1990.

HISTORY:

This Corner was not originally set by the Government Surveyor. This Corner has been accepted and used since before 1998, as evidenced by a recording under Act 74 of the Public Acts of 1970 by Patrick L. Hastings, Surveyor, in Liber 18918, Page

COLLATERAL EVIDENCE:
We set a 5/8" iron rod and remonumentation cap on the Township Line 0.37 feet North of the iron rod witnessed by Mr. Hastings. The South 1/4 Corner of Section 32 of Highland Township is 323.25 feet East of this Corner. Bear in mind that there is a 5/8" iron rod 0.39 feet South of the square stone for the South 1/4 Corner of Section 32, probably placed to make the stone dip. We found an iron rod and cap #17023 at the Northeast corner of fence lines 33.29 feet to the South. We measured 0.22 feet more than the recorded distance to the South 1/4 Corner of Section 5 and 0.13 feet less than the recorded distance to the Southwest Corner of Section 32 of Highland Township. We searched at least 50 feet in each direction for other stakes, and found none that might represent the Corner.

SURVEYOR'S RECOMMENDATIONS:

This corner location, although not established by an original government survey, is accepted by the Contractor and is generally accepted by Professional Surveyors as the best available evidence of the position of the corner. Therefore, I recommend that the Peer Review Group accept this Corner as monumented, with the references as shown on the enclosed form prepared according to Act 74 of the Public Acts of 1970.

Grant J. Ward, R.L.S. License No. 22445

> SURVEY & REMONUMENTATION

> > MAR 21 2000

SECTION