

LIBER 21028 PAGE 501  
**LAND CORNER RECORDATION CERTIFICATE 25864**  
 Filing Requirement of Act 74, Mich. P.A. 1970

For corners in

Oakland Located in: \_\_\_\_\_ Corner Code # \_\_\_\_\_  
 (County)

1. Public Land Survey T 2N R 7E \_\_\_\_\_ D-5  
 T \_\_\_\_\_ R \_\_\_\_\_  
 T \_\_\_\_\_ R \_\_\_\_\_  
 T \_\_\_\_\_ R \_\_\_\_\_
2. Property Controlling in Section S \_\_\_\_\_ T \_\_\_\_\_ R \_\_\_\_\_  
 S \_\_\_\_\_ T \_\_\_\_\_ R \_\_\_\_\_
3. Miscellaneous Property in Sec. S \_\_\_\_\_ T \_\_\_\_\_ R \_\_\_\_\_  
 S \_\_\_\_\_ T \_\_\_\_\_ R \_\_\_\_\_

**SURVEY &  
 REMONUMENTATION**

MAR 21 2000

LIBER 21028 PAGE 501  
 \$9.00 MISC RECORDING  
 \$2.00 REMONUMENTATION  
 01/27/2000 08:21:22 A.M. RECEIPT# 6667  
 PAID: RECORDED - OAKLAND COUNTY  
 G. WILLIAM CADDELL, CLERK/REGISTER OF DEEDS

Compliance with  
 ACT 345, P.A. 1990

APPROVED ON: 7-28-99 JIL  
 OAKLAND COUNTY REMONUMENTATION  
 PEER GROUP COMMITTEE

Register of Deeds Stamp & File Number

4. Lot No. \_\_\_\_\_, Recorded Plat \_\_\_\_\_ SECTION \_\_\_\_\_  
 5. Private Claims \_\_\_\_\_

I, Grant J. Ward, R.L.S., in a field survey on December 7, 1998 do hereby state that under requirements of P.A. 74, Michigan P.A. of 1970, the corner points mentioned in lines 1 and 2 above were in conformance with regulations and rules therefore as required in the current manual of survey instructions of the United States Department of the Interior, Bureau of Land Management or by a decree of a Court of Law and /or that the corner points mentioned in lines 3, 4 and 5 above were in conformance with the rules of the Michigan Board of Land Surveyors or by a Decree of a Court of Law; established, re-established, monumented, recovered, found as expressed below:

NOTE: Not more than 2 corners, all in the same town and range, may be recorded on this certificate.

	A	B	C	D	E	F	G	H	I	J	K	L	M
1													
2		6		5		4		3		2		1	
3													
4		7		8		9		10		11		12	
5				●									
6		18		17		16		15		14		13	
7													
8		19		20		21		22		23		24	
9													
10		30		29		28		27		26		25	
11													
12		31		32		33		34		35		36	
13													

A. Description of original monument and accessories and/or subsequent restoration:

D-5 Post, per G.L.O. Notes.

B. Description of corner evidence found and/or method applied in restoring or reestablishing corner:


D-5 North 1/4 Corner of Section 17, T. 2 N., R. 7 E. Found MAG Nail in Centerline of General Motors Road.

Previously Recorded in L. 18599 P. 10 (2), L. 7288 P. 543 (1) and L. 11779 P. 221 (2) of Oakland County Records.

(n) Indicates the number of references that confirms this corner by dimensional tie.

This corner location is accepted by the contractor and is generally accepted by professional surveyors as the best available evidence of the position of the original corner.

C. Description of monument for corner and accessories established to perpetuate locating the position of the corner:

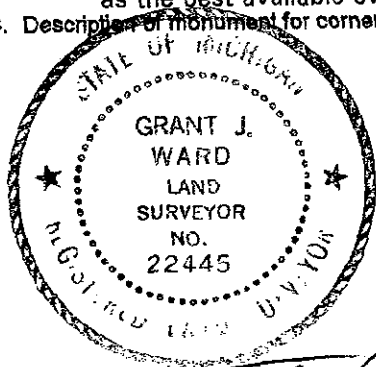

- |         |   |
|---------|---|
| D-5     | Set 5/8" Iron Rod, Remonumentation Cap and Monument Box.                      |
| N 25° E | 69.97' Set 60d Nail & Remonumentation Disc in West face of Subdivision Sign.  |
| S 55° E | 77.05' Set 60d Nail & Remonumentation Disc in Southwest face of 10" Cherry.   |
| S 05° W | 48.03' Set 60d Nail & Remonumentation Disc in East face of 30" Oak.           |
| N 50° W | 59.26" Set 60d Nail & Remonumentation Disc in Southwest face of Utility Pole. |

Signed by \_\_\_\_\_  
 Surveyor's Michigan License No. 22445

Date July 12, 1999

JULY 10, 1999

Corner Code: D-5

DOSSIER FOR: THE SOUTH 1/4 CORNER OF SECTION 8, MILFORD TOWNSHIP, T 2 N, R 7 E, OAKLAND COUNTY, MICHIGAN. Prepared under contract with the County of Oakland Under Act 345 of the Public Acts of 1990.

**HISTORY:**

This Corner has been accepted and used since before 1934 as witnessed by the Road Commission for Oakland County at that time. It was recorded under Act 74 of the Public Acts of 1970 in Liber 7288, Page 543, by Huston K. Kennedy, Surveyor in 1978.

**COLLATERAL EVIDENCE:**

This Corner lies in the Centerline of General Motors Road 30 feet West of the Centerline of Skyline Drive. We found a MAG nail and set a 5/8" iron rod and remonumentation cap in a new monument box in its place. There is a concrete monument laying down 60.19 feet Northerly of the Section Line 30.35 feet Westerly of the Corner and another concrete monument 60.10 feet Northerly of the Section Line 78.58 feet Easterly of the Corner. We measured 0.39 feet more and 0.66 feet less than the record distances to the adjacent Section Corners West and East of the Corner respectively. We searched at least 50 feet in each direction for other stakes and found none that might represent the Corner.

**SURVEYOR'S RECOMMENDATIONS:**

This corner location is accepted by the Contractor and is generally accepted by Professional Surveyors as the best available evidence of the position of the original Corner. Therefore, I recommend that the Peer Review Group accept this Corner as monumented, with the references as shown on the enclosed form prepared according to Act 74 of the Public Acts of 1970.

---

Grant J. Ward, R.L.S.  
License No. 22445

SURVEY &  
REMONUMENTATION

MAR 21 2000

SECTION