

LIBER 21028 503
Mulford
LAND CORNER RECORDATION CERTIFICATE
 Filing Requirement of Act 74, Mich. P.A. 1970

For corners in
Oakland Located in: Corner Code #
 (County)

1. Public Land Survey T 2N R 7E D-7
 T _____ R _____
 T _____ R _____
 T _____ R _____

2. Property Controlling S _____ T _____ R _____
 in Section S _____ T _____ R _____
 3. Miscellaneous S _____ T _____ R _____
 Property in Sec. S _____ T _____ R _____

SURVEY & REMONUMENTATION
MAR 21 2000

4. Lot No. _____, Recorded Plat _____ SECTION _____
 5. Private Claims _____

25865

LIBER 21028 PAGE 503
 \$9.00 MISC RECORDING
 \$2.00 REMONUMENTATION
 01/27/2000 08:21:22 A.M. RECEIPT# 6667
 PAID RECORDED - OAKLAND COUNTY
 G. WILLIAM CADDELL, CLERK/REGISTER OF DEEDS
 ACT 345, P.A. 1990

APPROVED ON: 7-28-99 JK
 OAKLAND COUNTY REMONUMENTATION
 PEER GROUP COMMITTEE

Register of Deeds Stamp & File Number

I, Grant J. Ward, R.L.S., in a field survey on December 4, 1998 do hereby state that under requirements of P.A. 74, Michigan P.A. of 1970, the corner points mentioned in lines 1 and 2 above were in conformance with regulations and rules therefore as required in the current manual of survey instructions of the United States Department of the Interior, Bureau of Land Management or by a decree of a Court of Law and /or that the corner points mentioned in lines 3, 4 and 5 above were in conformance with the rules of the Michigan Board of Land Surveyors or by a Decree of a Court of Law; established, re-established, monumented, recovered, found as expressed below:

NOTE: Not more than 2 corners, all in the same town and range, may be recorded on this certificate.

	A	B	C	D	E	F	G	H	I	J	K	L	M
1													
2		6		5		4		3		2		1	
3													
4		7		8		9		10		11		12	
5													
6		18		17		16		15		14		13	
7				●									
8		19		20		21		22		23		24	
9													
10		30		29		28		27		26		25	
11													
12		31		32		33		34		35		36	
13													

A. Description of original monument and accessories and/or subsequent restoration:

D-7 Post, per G.L.O. Notes.

B. Description of corner evidence found and/or method applied in restoring or reestablishing corner:

D-7 North 1/4 Corner of Section 20, T. 2 N., R. 7 E. Found 1/2" Iron Rod.


Previously Recorded in L. 6965 P. 92 (3), L. 10930 P. 206 (4) and L. 11025 P. 269 (4) of Oakland County Records.

(n) Indicates the number of references that confirms this corner by dimensional tie.

This corner location is accepted by the contractor and is generally accepted by professional surveyors as the best available evidence of the position of the original corner.

C. Description of monument for corner and accessories established to perpetuate locating the position of the corner:

- D-7 Set Monument and Remonumentation Cap.
 N 05° E 24.92' Set 60d Nail & Remonumentation Disc in East face of 16" Oak.
 S 80° E 23.21' Set 60d Nail & Remonumentation Disc in face of 12" Hickory.
 South 17.17' Set 60d Nail & Remonumentation Disc in West face of 10" Cherry.
 West 9.95' Set 60d Nail & Remonumentation Disc in South face of 10" Ash.

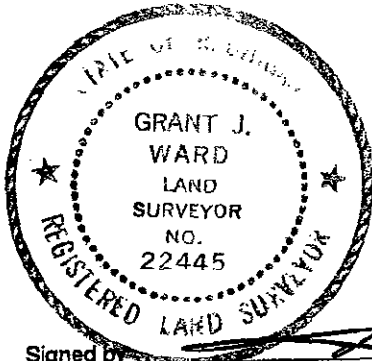

Signed by _____
 Surveyor's Michigan License No. 22445

Date July 12, 1999

JULY 10, 1999

Corner Code: D-7

DOSSIER FOR: THE SOUTH 1/4 CORNER OF SECTION 17, MILFORD TOWNSHIP,
T 2 N, R 7 E, OAKLAND COUNTY, MICHIGAN. Prepared under contract with the
County of Oakland Under Act 345 of the Public Acts of 1990.

HISTORY:

This Corner has been accepted and used since before 1977, as evidenced by the Corner being recorded under Act 74 of the Public Acts of 1970, by Huston K. Kennedy, R.L.S. as recorded in Liber 6965, Page 92.

COLLATERAL EVIDENCE:

This Corner lies 5 feet West of the intersection of very old fallen down fences running North, South, East and West. We set a concrete monument with remonumentation cap in place of a 1/2" iron rod we found. We measured 0.07 feet less and 4.89 feet more than the recorded distances to the Southwest and the Southeast Corners of Section 17 respectively. We searched at least 50 feet in each direction for other stakes and found none that might represent the Corner.

SURVEYOR'S RECOMMENDATIONS:

This corner location is accepted by the Contractor and is generally accepted by Professional Surveyors as the best available evidence of the position of the original Corner. Therefore, I recommend that the Peer Review Group accept this Corner as monumented, with the references as shown on the enclosed form prepared according to Act 74 of the Public Acts of 1970, while considering the other iron we found near the Corner.

Grant J. Ward, R.L.S.
License No. 22445

SURVEY &
REMONUMENTATION

MAR 21 2000

SECTION