

LIBER 21028 ... 507
W. Ford

LAND CORNER RECORDATION CERTIFICATE
 Filing Requirement of Act 74, Mich. P.A. 1970

25867

LIBER 21028 PAGE 507
 \$9.00 MISC RECORDING
 \$2.00 REMONUMENTATION
 01/27/2000 08:21:22 A.M. RECEIPT# 66
 PAID RECORDED - OAKLAND COUNTY
 G. WILLIAM CADDELL, CLERK/REGISTER OF

For corners in

Oakland
 (County)

Located in:

Corner Code #

- | | | | |
|------------------------------------|--------------|--------------|------------------------|
| 1. Public Land Survey | T <u>2</u> N | R <u>7</u> E | <u>D-11</u> |
| | T <u> </u> | R <u> </u> | |
| | T <u> </u> | R <u> </u> | <u>SURVEY &</u> |
| | T <u> </u> | R <u> </u> | <u>REMONUMENTATION</u> |
| 2. Property Controlling in Section | S <u> </u> | T <u> </u> | R <u> </u> |
| 3. Miscellaneous Property in Sec. | S <u> </u> | T <u> </u> | R <u> </u> |
| | S <u> </u> | T <u> </u> | R <u> </u> |

MAR 21 2000

SECTION

4. Lot No. _____, Recorded Plat _____
 5. Private Claims _____

Compliance with
 ACT 345, P.A. 1990
 APPROVED ON: 9-15-99 JH
 OAKLAND COUNTY REMONUMENTATION
 PEER GROUP COMMITTEE
 Register of Deeds Stamp & File Number

A	B	C	D	E	F	G	H	I	J	K	L
1											
2	6	5	4	3	2						
3											
4	7	8	9	10	11						
5											
6	18	17	16	15	14						
7											
8	19	20	21	22	23						
9											
10	30	29	28	27	26						
11											
12	31	32	33	34	35						
13											

I, Grant J. Ward, R.L.S., in a field survey on June 29, 1999 do hereby state that under requirements of P.A. 74, Michigan P.A. of 1970, the corner points mentioned in lines 1 and 2 above were in conformance with regulations and rules therefore as required in the current manual of survey instructions of the United States Department of the Interior, Bureau of Land Management or by a decree of a Court of Law and /or that the corner points mentioned in lines 3, 4 and 5 above were in conformance with the rules of the Michigan Board of Land Surveyors or by a Decree of a Court of Law; established, re-established, monumented, recovered, found as expressed below:

NOTE: Not more than 2 corners, all in the same town and range, may be recorded on this certificate.

A. Description of original monument and accessories and/or subsequent restoration:

D-11 Post, per G.L.O. Notes.

B. Description of corner evidence found and/or method applied in restoring or reestablishing corner:


D-11 North 1/4 Corner of Section 32, T. 2 N., R. 7 E.

Previously Unrecorded.

This corner location is accepted by the contractor and is generally accepted by professional surveyors as the best available evidence of the position of the original corner.

C. Description of monument for corner and accessories established to perpetuate locating the position of the corner:

- | | |
|---------|---|
| D-11 | Set 5/8" Iron Rod, Remonumentation Cap and Monument Box. |
| North | 35.65' Set 60d Nail & Remonumentation Disc in West face of 24" Oak. |
| S 20° E | 35.21' Set 60d Nail & Remonumentation Disc in Northeast face of 8" Oak. |
| S 55° W | 34.87' Set 60d Nail & Remonumentation Disc in Top of 6" Stump. |
| N 20° W | 47.76' Set 60d Nail & Remonumentation Disc in East face of 30" Oak. |

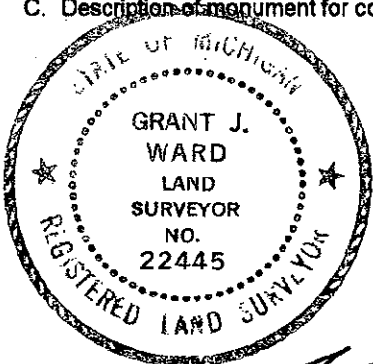

Signed by *Grant J. Ward*
 Surveyor's Michigan License No. 22445

Date July 12, 1999

AUGUST 29, 1999

Corner Code: D-11

DOSSIER FOR: THE SOUTH 1/4 CORNER OF SECTION 29, MILFORD TOWNSHIP,
T 2 N, R 7 E, OAKLAND COUNTY, MICHIGAN. Prepared under contract with the
County of Oakland Under Act 345 of the Public Acts of 1990.

HISTORY:

The Corner we set is based on coordinates taken from an unrecorded survey for the
Huron-Clinton Metropolitan Authority (HCMA) in 1945. This Corner has not been
recorded.

COLLATERAL EVIDENCE:

We set a 5/8" iron rod and remonumentation cap in a new monument box at the coor-
dinates shown on the old survey, based on the coordinates for the three Govern-
ment Corners along the South Line of Section 29 from the old HCMA Survey. This
Corner lies 2.4 feet North of the Centerline of Maple Beach Drive. There is no
evidence of occupation in the vicinity of this Corner. We reset this Corner at the
recorded distances to the two adjacent Government Corners. We searched at
least 50 feet in each direction for other stakes and found none that might repre-
sent the Corner.

SURVEYOR'S RECOMMENDATIONS:

This corner location is accepted by the Contractor and is generally accepted by Profes-
sional Surveyors as the best available evidence of the position of the original Cor-
ner. Therefore, I recommend that the Peer Review Group accept this Corner as
monumented, with the references as shown on the enclosed form prepared accord-
ing to Act 74 of the Public Acts of 1970.

Grant J. Ward, R.L.S.
License No. 22445

SURVEY &
REMONUMENTATION

MAR 21 2000

SECTION