

SURVEY & REMONUMENTATION

MAY 24 2000

LIBER 21143 061

58659

SECTION

LAND CORNER RECORDATION CERTIFICATE LIBER 21143 PAGE 61
Filing Requirement of Act 74, Mich. P.A. 1970 MISC RECORDING \$2.00 REMONUMENTATION 02/28/2000 01:52:10 P.M. RECEIPT# 16297
PAID RECORDED - OAKLAND COUNTY G. WILLIAM CADDELL, CLERK/REGISTER OF DEEDS

For corners in

Oakland (County)	Located In:	Corner Code #
1. Public Land Survey	T2N R 7E	E-2
	T R	
	T R	
	T R	
2. Property Controlling In Section	S T R	
	S T R	
3. Miscellaneous Property in Sec.	S T R	
	S T R	

Compliance with ACT 345, P.A. 1990
APPROVED ON: 7-14-99 JH
OAKLAND COUNTY REMONUMENTATION BOARD
Register of Deeds Stamp & File Number

4. Lot No. _____, Recorded Plat _____
5. Private Claims _____

I, Grant J. Ward, R.L.S., in a field survey on November 6, 1999 do hereby state that under requirements of P.A. 74, Michigan P.A. of 1970, the corner points mentioned in lines 1 and 2 above were in conformance with regulations and rules therefore as required in the current manual of survey instructions of the United States Department of the Interior, Bureau of Land Management or by a decree of a Court of Law and /or that the corner points mentioned in lines 3, 4 and 5 above were in conformance with the rules of the Michigan Board of Land Surveyors or by a Decree of a Court of Law; established, re-established, monumented, recovered, found as expressed below:

NOTE: Not more than 2 corners, all in the same town and range, may be recorded on this certificate.

	A	B	C	D	E	F	G	H	I	J	K	L	M
1													
2	6			5	●	4			3		2		1
3													
4	7			8		9			10		11		12
5													
6	18			17		16			15		14		13
7													
8	19			20		21			22		23		24
9													
10	30			29		28			27		26		25
11													
12	31			32		33			34		35		36
13													

A. Descrip' of original monument and accessories and/or subsequent restoration:
E-2 Post, per G.L.O. Notes.

B. Description of corner evidence found and/or method applied in restoring or reestablishing corner:


E-2 East 1/4 Corner of Section 5, T. 2 N., R. 7 E. Set a Reference Corner 875.00 Feet South of the Corner on the Section Line.

Previously Recorded in L. 8644 P. 189 (O), L. 10841 P. 330 (O), L. 11887 P. 266 (O), L. 12652 P. 104 (O) of Oakland County Records.

This corner location is accepted by the Contractor and is generally accepted by Professional Surveyors as the best available evidence of the position of the original corner.

C. Description of monument for corner and accessories established to perpetuate locating the position of the corner:

- E-2 Set 5/8" Iron Rod & Remonumentation Cap 242.00 Feet South of the Water's Edge.
- West 104.81' Set 60d Nail & Remonumentation Disc in West face of 16" Cherry.
- S 15° W 108.14' Set 60d Nail & Remonumentation Disc in Northeast face of 14"/18" Twin Oak.
- N 40° W 26.40' Set 60d Nail & Remonumentation Disc in Northeast face of 18" Oak.
- N 20° W 37.11' Set 60d Nail & Remonumentation Disc in East face of 10" Cherry.

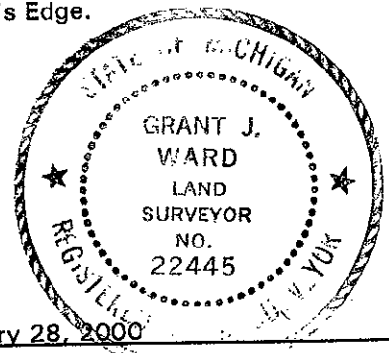

Signed by [Signature]
Surveyor's Michigan License No. 22445

Date February 28, 2000