

25871

LIBER 21028 PAGE 515
 \$9.00 MISC RECORDING
 \$2.00 REMONUMENTATION
 01/27/2000 08:21:22 A.M. RECEIPT# 66
 PAID RECORDED - OAKLAND COUNTY
 G. WILLIAM CADDELL, CLERK/REGISTER OF

For corners in Oakland Located In: _____ Corner Code # _____
 (County)

1. Public Land Survey T 2N R 7E E-5
 T _____ R _____
 T _____ R _____
 T _____ R _____

2. Property Controlling S _____ T _____ R _____
 In Section S _____ T _____ R _____

3. Miscellaneous S _____ T _____ R _____
 Property in Sec. S _____ T _____ R _____

**SURVEY &
 REMONUMENTATION**


MAR 21 2000

SECTION

4. Lot No. _____, Recorded Plat _____
 5. Private Claims _____

Compliance with
 ACT 345, P.A. 1990
 APPROVED ON: 9-15-99 SK
 OAKLAND COUNTY REMONUMENTATION
 PEER GROUP COMMITTEE
 Register of Deeds Stamp & File Number

I, Grant J. Ward, R.L.S., in a field survey on December 7, 1998 do hereby state that under requirements of P.A. 74, Michigan P.A. of 1970, the corner points mentioned in lines 1 and 2 above were in conformance with regulations and rules therefore as required in the current manual of survey instructions of the United States Department of the Interior, Bureau of Land Management or by a decree of a Court of Law and /or that the corner points mentioned in lines 3, 4 and 5 above were in conformance with the rules of the Michigan Board of Land Surveyors or by a Decree of a Court of Law; established, re-established, monumented, recovered, found as expressed below:

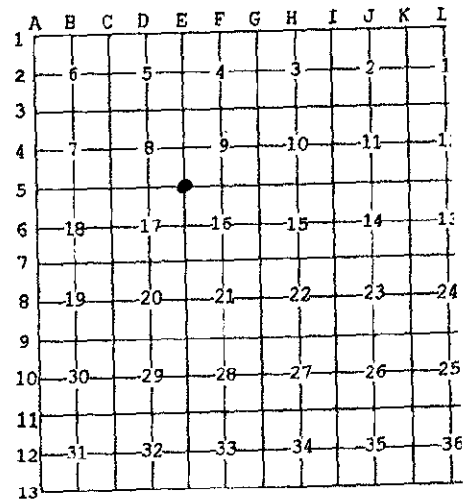

NOTE: Not more than 2 corners, all in the same town and range, may be recorded on this certificate.

A. Description of original monument and accessories and/or subsequent restoration:

E-5 Post, per G.L.O. Notes.

B. Description of corner evidence found and/or method applied in restoring or reestablishing corner:

E-5 Northwest Corner of Section 16, T. 2 N., R. 7 E. Found 1/2" Iron Rod 1' South of the Centerline of General Motors Road.


Previously Recorded in L. 6965 P. 92 (3), L. 11779 P. 221 (4) and L. 17936 P. 230 (3) of Oakland County Records.

(n) Indicates the number of references that confirms this corner by dimensional tie.

This corner location is accepted by the contractor and is generally accepted by professional surveyors as the best available evidence of the position of the original corner.

C. Description of monument for corner and accessories established to perpetuate locating the position of the corner:

- | | |
|---------|---|
| E-5 | Set 5/8" Iron Rod & Cap in existing Monument Box. |
| S 55° E | 55.06' Set 60d Nail & Remonumentation Disc in Southwest face of Utility Pole. |
| S 40° E | 46.03' Set 60d Nail & Remonumentation Disc in Southwest face of 12" Hickory. |
| S 30° W | 45.06' Set 60d Nail & Remonumentation Disc in Northwest face of Utility Pole. |
| N 30° W | 35.49" Set 60d Nail & Remonumentation Disc in Northeast face of Utility Pole. |

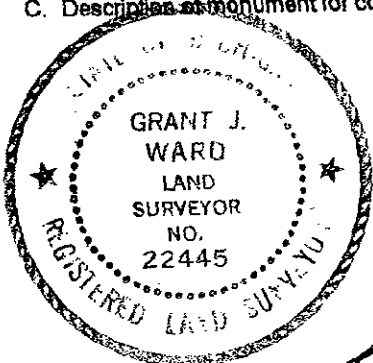

Signed by [Signature]
 Surveyor's Michigan License No. 22445

Date July 12, 1999

AUGUST 24, 1999

Corner Code: E-5

DOSSIER FOR: THE SOUTHWEST CORNER OF SECTION 9, MILFORD TOWNSHIP, T 2 N, R 7 E, OAKLAND COUNTY, MICHIGAN. Prepared under contract with the County of Oakland Under Act 345 of the Public Acts of 1990.

HISTORY:

This Corner has been accepted and used since before 1959 as witnessed by the Road Commission for Oakland County at that time. It was recorded under Act 74 of the Public Acts of 1970 in Liber 6965, Page 92, by Huston K. Kennedy, Surveyor in 1977.

COLLATERAL EVIDENCE:

We set a 5/8" iron rod and remonumentation cap in place of a 1/2" iron rod in an existing monument box 1 foot South and 5 feet West of the centerline intersection of General Motors Road with Granger Road. We measured 0.21 feet, 6.89 feet, 0.03 feet and 0.66 feet less than the record distances to the adjacent Government Corners to the North, East, South and West, respectively. We searched at least 50 feet in each direction for other stakes and found none that might represent the Corner.

SURVEYOR'S RECOMMENDATIONS:

This corner location is accepted by the Contractor and is generally accepted by Professional Surveyors as the best available evidence of the position of the original Corner. Therefore, I recommend that the Peer Review Group accept this Corner as monumented, with the references as shown on the enclosed form prepared according to Act 74 of the Public Acts of 1970.

Grant J. Ward, R.L.S.
License No. 22445

SURVEY &
REMONUMENTATION

MAR 21 2000

SECTION