

*McFord*

LAND CORNER RECORDATION CERTIFICATE  
Filing Requirement of Act 74, Mich. P.A. 1970

25876

LIBER 21028 PAGE 525  
\$9.00 MISC RECORDING  
\$2.00 REMONUMENTATION  
01/27/2000 08:21:22 A.M. RECEIPT# 666;  
PAID RECORDED - OAKLAND COUNTY  
G. WILLIAM CADDELL, CLERK/REGISTER OF I

For corners in

Oakland  
(County)

Located in:

Corner Code #

1. Public Land Survey

T 2 N R 7 E E-10

T R  
T R SURVEY &  
T R REMONUMENTATION

2. Property Controlling in Section

S

T R

3. Miscellaneous Property in Sec.

S

T R

MAR 21 2000

S

T R

SECTION

Compliance with  
ACT 345, P.A. 1990

APPROVED ON: 9-29-99 JK  
OAKLAND COUNTY REMONUMENTATION  
PEER GROUP COMMITTEE

Register of Deeds Stamp & File Number

4. Lot No. \_\_\_\_\_, Recorded Plat \_\_\_\_\_  
5. Private Claims \_\_\_\_\_

I, Grant J. Ward, R.L.S., in a field survey on July 7, 1999 do hereby state that under requirements of P.A. 74, Michigan P.A. of 1970, the corner points mentioned in lines 1 and 2 above were in conformance with regulations and rules therefore as required in the current manual of survey instructions of the United States Department of the Interior, Bureau of Land Management or by a decree of a Court of Law and /or that the corner points mentioned in lines 3, 4 and 5 above were in conformance with the rules of the Michigan Board of Land Surveyors or by a Decree of a Court of Law; established, re-established, monumented, recovered, found as expressed below:

NOTE: Not more than 2 corners, all in the same town and range, may be recorded on this certificate.

	A	B	C	D	E	F	G	H	I	J	K
1											
2		6		5		4		3		2	
3											
4		7		8		9		10		11	
5											
6		18		17		16		15		14	
7											
8		19		20		21		22		23	
9											
10		30		29		28		27		26	
11											
12		31		32		33		34		35	
13											

A. Description of original monument and accessories and/or subsequent restoration:

E-10 Post, per G.L.O. Notes.

B. Description of corner evidence found and/or method applied in restoring or reestablishing corner:

E-10 East 1/4 Corner of Section 29, T. 2 N., R. 7 E.


Previously Unrecorded.

This corner location is a careful and faithful re-established of the position of the original corner.

*JK*  
*R*

C. Description of monument for corner and accessories established to perpetuate locating the position of the corner:

- E-10 Set Monument and Remonumentation Cap.
- N 30° E 36.87' Set 60d Nail & Remonumentation Disc in West face of 36" Oak.
- N 70° E 68.65' Set 60d Nail & Remonumentation Disc in Southeast face of 12" Oak.
- S 80° W 12.51' Set 60d Nail & Remonumentation Disc in South face of 16" Cherry.
- West 40.49' Set 60d Nail & Remonumentation Disc in Southeast face of 16" Cherry.

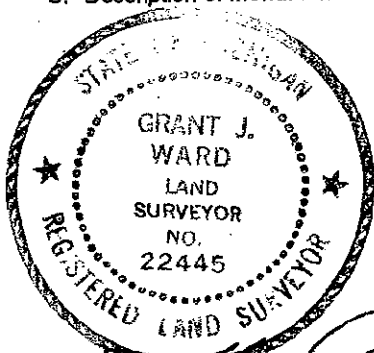

Signed by: \_\_\_\_\_  
Surveyor's Michigan License No. 22445

Date September 30, 1999

SEPTEMBER 19, 1999

Corner Code: E-10

DOSSIER FOR: THE WEST 1/4 CORNER OF SECTION 28, MILFORD TOWNSHIP, T 2 N, R 7 E, OAKLAND COUNTY, MICHIGAN. Prepared under contract with the County of Oakland Under Act 345 of the Public Acts of 1990.

**HISTORY:**

This Corner has not been previously recorded, there is no visible occupation and we have no surveys showing its location.

**COLLATERAL EVIDENCE:**

We set a concrete monument and remonumentation cap midway and on line between the adjacent Government Corners by single proportional measurement according to the Government Instructions for setting a lost Corner. We measured about 11.5 feet less than the GLO for the mile. We searched at least 50 feet in each direction for other stakes and found none that might represent the Corner.

**SURVEYOR'S RECOMMENDATIONS:**

This corner location is a careful and faithful re-establishment of the position of the original Corner. Therefore, I recommend that the Peer Review Group accept this Corner as monumented, with the references as shown on the enclosed form prepared according to Act 74 of the Public Acts of 1970.

---

Grant J. Ward, R.L.S.  
License No. 22445

SURVEY &  
REMONUMENTATION

MAR 21 2000

SECTION