

LIBER 21028, 529
M. Ward
LAND CORNER RECORDATION CERTIFICATE
 Filing Requirement of Act 74, Mich. P.A. 1970

25878

LIBER 21028 PAGE 529
 \$9.00 MISC RECORDING
 \$2.00 REMONUMENTATION
 01/27/2000 08:21:22 A.M. RECEIPT
 PAID RECORDED - OAKLAND COUNTY
 G. WILLIAM CADDELL, CLERK/REGISTE

For corners in
Oakland
 (County)

Located In: _____ Corner Code # _____

1. Public Land Survey T2N R7E E-12
 T___R___
 T___R___ **SURVEY &**
 T___R___ **REMONUMENTATION**

2. Property Controlling S___T___R___
 in Section S___T___R___ **MAR 21 2000**

3. Miscellaneous S___T___R___
 Property in Sec. S___T___R___ **SECTION**

Compliance with
 ACT 345, P.A. 1990
 APPROVED ON: 9-24-99 JZ
 OAKLAND COUNTY REMONUMENTATION
 PEER GROUP COMMITTEE
 Register of Deeds Stamp & File Numt

4. Lot No. _____, Recorded Plat _____
 5. Private Claims _____

I, Grant J. Ward, R.L.S., in a field survey on October 21, 1998 do hereby state that under requirements of P.A. 74, Michigan P.A. of 1970, the corner points mentioned in lines 1 and 2 above were in conformance with regulations and rules therefore as required in the current manual of survey instructions of the United States Department of the Interior, Bureau of Land Management or by a decree of a Court of Law and /or that the corner points mentioned in lines 3, 4 and 5 above were in conformance with the rules of the Michigan Board of Land Surveyors or by a Decree of a Court of Law; established, re-established, monumented, recovered, found as expressed below:

NOTE: Not more than 2 corners, all in the same town and range, may be recorded on this certificate.

	A	B	C	D	E	F	G	H	I	J	K
1											
2		5		5		4		3		2	
3											
4		7		8		9		10		11	
5											
6		18		17		16		15		14	
7											
8		19		20		21		22		23	
9											
10		30		29		28		27		26	
11											
12		31		32		33		34		35	
13											

A. Description of original monument and accessories and/or subsequent restoration:

E-12 Post, per G.L.O. Notes.


B. Description of corner evidence found and/or method applied in restoring or reestablishing corner:

E-12 West 1/4 Corner of Section 33, T. 2 N., R. 7 E. Found 5/8" Iron Rod.
 Previously Unrecorded.

This corner location is accepted by the contractor and is generally accepted by professional surveyors as the best available evidence of the position of the original corner.

C. Description of monument for corner and accessories established to perpetuate locating the position of the corner:

- E-12 Set Monument and Remonumentation Cap.
- N 50° E 40.49' Set 60d Nail & Remonumentation Disc in Northwest face of 14" Cherry.
 - S 20° E 52.34' Set 60d Nail & Remonumentation Disc in East face of 18" Ash.
 - N 55° W 65.25' Set 60d Nail & Remonumentation Disc in Northeast face of 16" Oak.
 - N 25° W 49.17' Set 60d Nail & Remonumentation Disc in West face of 48" Oak.

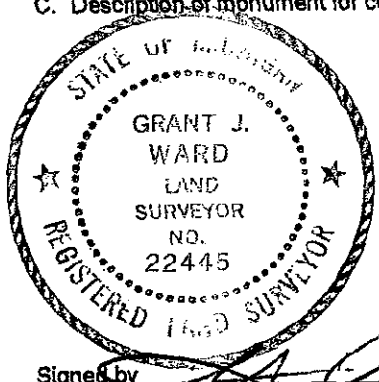

Signed by *Grant J. Ward*
 Surveyor's Michigan License No. 22445

Date July 12, 1999

NOVEMBER 8, 1999

Corner Code: E-12

DOSSIER FOR: THE EAST 1/4 CORNER OF SECTION 32, MILFORD TOWNSHIP, T 2 N, R 7 E, OAKLAND COUNTY, MICHIGAN. Prepared under contract with the County of Oakland Under Act 345 of the Public Acts of 1990.

HISTORY:

This Corner has been accepted and used since before 1934 as witnessed by the Road Commission for Oakland County at that time. This Corner has not been previously recorded. This Corner has been perpetuated by the Huron-Clinton Metropolitan Authority (HCMA) with an unrecorded survey.

COLLATERAL EVIDENCE:

We found a 5/8" iron rod and set a concrete monument with a remonumentation cap in its place. This Corner lies in the Northwest quadrant of the intersection of asphalt bike paths. This Corner falls within 0.2 feet of the record coordinates of the HCMA survey. We measured 0.17 feet more and 0.17 feet less than the recorded dimensions shown on the HCMA survey to the Northeast and the Southeast Corners of Section 32 respectively. We searched at least 50 feet in each direction for other stakes and found none that might represent the Corner.

SURVEYOR'S RECOMMENDATIONS:

This corner location is accepted by the Contractor and is generally accepted by Professional Surveyors as the best available evidence of the position of the original Corner. Therefore, I recommend that the Peer Review Group accept this Corner as monumented, with the references as shown on the enclosed form prepared according to Act 74 of the Public Acts of 1970.

Grant J. Ward, R.L.S.
License No. 22445

SURVEY &
REMONUMENTATION

MAR 21 2000

SECTION