

SURVEY & REMONUMENTATION

LIBR 21143 063

POST MAY 24 2000
SECTION

LAND CORNER RECORDATION CERTIFICATE
Filing Requirement of Act 74, Mich. P.A. 1970

58660

LYDER 21143 PAGE 63
\$9.00 MISC RECORDING
\$2.00 REMONUMENTATION
02/28/2000 01:52:10 P.M. RECEIPT# 16297
PAID RECORDED - OAKLAND COUNTY
G. WILLIAM CADDELL, CLERK/REGISTER OF DEE

For corners in

Oakland Located in: Corner Code #
(County)

1. Public Land Survey	T	2N	R	7E	E-13
	T		R		
	T		R		
	T		R		
2. Property Controlling In Section	S	T	R		
	S	T	R		
3. Miscellaneous Property in Sec.	S	T	R		
	S	T	R		

Compliance with ACT 345, P.A. 1990

PROVED ON: 12-7-99 JK
OAKLAND COUNTY REMONUMENTATION PEER GROUP COMMITTEE

Register of Deeds Stamp & File Number

4. Lot No. _____, Recorded Plat _____
5. Private Claims _____

I, Grant J. Ward, R.L.S., in a field survey on June 17, 1998 do hereby state that under requirements of P.A. 74, Michigan P.A. of 1970, the corner points mentioned in lines 1 and 2 above were in conformance with regulations and rules therefore as required in the current manual of survey instructions of the United States Department of the Interior, Bureau of Land Management or by a decree of a Court of Law and /or that the corner points mentioned in lines 3, 4 and 5 above were in conformance with the rules of the Michigan Board of Land Surveyors or by a Decree of a Court of Law; established, re-established, monumented, recovered, found as expressed below:

NOTE: Not more than 2 corners, all in the same town and range, may be recorded on this certificate.

	A	B	C	D	E	F	G	H	I	J	K	L
2	6		5		4		3		2		1	
3												
4	7		8		9		10		11		12	
5												
6	18		17		16		15		14		13	
7												
8	19		20		21		22		23		24	
9												
10	30		29		28		27		26		25	
11												
12	31		32		33		34		35		36	
13												

A. Description of original monument and accessories and/or subsequent restoration:

E-13 Post, per G.L.O. Notes.

B. Description of corner evidence found and/or method applied in restoring or reestablishing corner:

E-13 Southeast Corner of Section 32, T. 2 N., R. 7 E. Found 1/2" Iron Rod in Concrete.


Previously Unrecorded.

This corner location is a careful and faithful re-establishment of the position of the original corner.

2P
R

C. Description of monument for corner and accessories established to perpetuate locating the position of the corner:

E-13 Capped Existing Iron in Concrete.
N 75° E 2.83' Set 60d Nail & Remonumentation Disc in Northwest face of 38" Oak.
S 65° W 11.24' Set 60d Nail & Remonumentation Disc in Southeast face of 36" Cherry.
West 27.90' Set 60d Nail & Remonumentation Disc in North face of 12" Sassafras.
N 10° W 14.11' Set 60d Nail & Remonumentation Disc in East face of 8" Hickory.
West 86.54' Found 1/2" Iron Rod on R.O.W. Fence.
S 83° W 86.68' Found 'X' on Rock 0.11' North of Township Line.

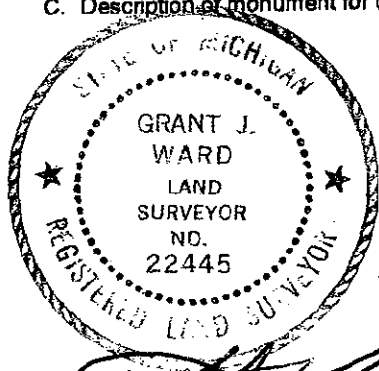

Signed by _____
Surveyor's Michigan License No. 22445

Date February 28, 2000