

LIBER 21028 PAGE 537
McHorse

25882

LAND CORNER RECORDATION CERTIFICATE
 Filing Requirement of Act 74, Mich. P.A. 1970

LIBER 21028 PAGE 537
 \$9.00 MISC RECORDING
 \$2.00 REMONUMENTATION
 01/27/2000 08:21:22 A.M. RECEIPT# 6667
 PAID RECORDED - OAKLAND COUNTY
 G. WILLIAM CADDELL, CLERK/REGISTER OF DEE

For corners in Oakland Located in: _____ Corner Code # _____
 (County)


1. Public Land Survey T 2N R 7E _____ F-7
 T _____ R _____
 T _____ R _____ SURVEY &
 T _____ R _____ REMONUMENTATION

2. Property Controlling S _____ T _____ R _____
 In Section S _____ T _____ R _____ MAR 21 2000
 3. Miscellaneous S _____ T _____ R _____
 Property in Sec. S _____ T _____ R _____ SECTION

4. Lot No. _____, Recorded Plat _____
 5. Private Claims _____

Compliance with
 ACT 345, P.A. 1999
 RECORDED ON: 7-14-99 JS
 OAKLAND COUNTY REMONUMENTATION
 RECORDER GROUP COMMITTEE
 Register of Deeds Stamp & File Number

I, Grant J. Ward, R.L.S., in a field survey on October 6, 1998 do hereby state that under requirements of P.A. 74, Michigan P.A. of 1970, the corner points mentioned in lines 1 and 2 above were in conformance with regulations and rules therefore as required in the current manual of survey instructions of the United States Department of the Interior, Bureau of Land Management or by a decree of a Court of Law and/or that the corner points mentioned in lines 3, 4 and 5 above were in conformance with the rules of the Michigan Board of Land Surveyors or by a Decree of a Court of Law; established, re-established, monumented, recovered, found as expressed below:

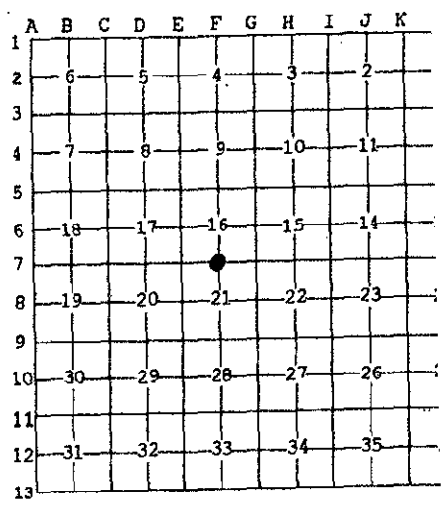

NOTE: Not more than 2 corners, all in the same town and range, may be recorded on this certificate.

A. Description of original monument and accessories and/or subsequent restoration:

F-7 Post, per G.L.O. Notes.


B. Description of corner evidence found and/or method applied in restoring or reestablishing corner:

F-7 North 1/4 Corner of Section 21, T. 2 N., R. 7 E. Found 1/2" Iron Rod.
 Previously Unrecorded.

This corner location is accepted by the contractor and is generally accepted by professional surveyors as the best available evidence of the position of the original corner.

C. Description of monument for corner and accessories established to perpetuate locating the position of the corner:

- F-7 Set 5/8" Iron Rod and Remonumentation Cap.
- N 50° E 31.23' Set 60d Nail & Remonumentation Disc in Southeast face of 8" Elm.
- South 28.64' Set 60d Nail & Remonumentation Disc in West face of 14" Oak.
- S 50° W 33.35' Set 60d Nail & Remonumentation Disc in Northwest face of 18" Oak.
- N 70° W 73.81' Set 60d Nail & Remonumentation Disc in Southwest face of 14" Oak.

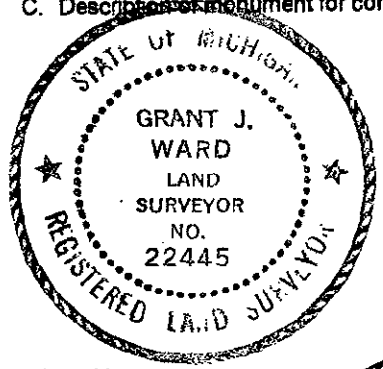

Signed by *Grant J. Ward*
 Surveyor's Michigan License No. 22445

Date July 12, 1999

JULY 3, 1999

Corner Code: F-7

DOSSIER FOR: THE SOUTH 1/4 CORNER OF SECTION 16, MILFORD TOWNSHIP,
T 2 N, R 7 E, OAKLAND COUNTY, MICHIGAN. Prepared under contract with the
County of Oakland Under Act 345 of the Public Acts of 1990.

HISTORY:

This Corner has been accepted and used since before 1935 as witnessed by the Road Commission for Oakland County at that time. It was also witnessed but not recorded by Donald W. Ross, Raymond J. Kostecke and David P. Smith as evidenced by unrecorded surveys in the dossiers.

COLLATERAL EVIDENCE:

We found a 1/2" iron rod and set a 5/8" iron rod and remonumentation cap in its place. This Corner lies 2 feet North of the Centerline of Dawson Road on line with a fence line to the South. There is no evidence of occupation to the North.

The measured dimensions to the Southwest Corner of Section 16 agrees with the recorded distances within 0.26 feet. There is an iron rod and cap #10702 32.97 feet South of the Corner.

We searched at least 50 feet in each direction for other stakes and found none that might represent the Corner.

SURVEYOR'S RECOMMENDATIONS:

This corner location is accepted by the Contractor and is generally accepted by Professional Surveyors as the best available evidence of the position of the original Corner. Therefore, I recommend that the Peer Review Group accept this Corner as monumented, with the references as shown on the enclosed form prepared according to Act 74 of the Public Acts of 1970.

Grant J. Ward, R.L.S.
License No. 22445

SURVEY &
REMONUMENTATION

MAR 21 2000

SECTION