

LIBER 21028 539
Mulford

25883

LIBER 21028 PAGE 539
 \$9.00 MISC RECORDING
 \$2.00 REMONUMENTATION
 07/27/2000 08:21:22 A.M. RECEIPT# 6667
 PAID RECORDED - OAKLAND COUNTY
 G. WILLIAM CADDELL, CLERK/REGISTER OF D

LAND CORNER RECORDATION CERTIFICATE
 Filing Requirement of Act 74, Mich. P.A. 1970

For corners in
Oakland
 (County)

Located In: _____ Corner Code # _____

1. Public Land Survey T 2N R 7E F-9
 T _____ R _____ SURVEY &
 T _____ R _____ REMONUMENTATION
 T _____ R _____

2. Property Controlling S _____ T _____ R _____ MAR 21 2000
 in Section S _____ T _____ R _____

3. Miscellaneous S _____ T _____ R _____
 Property in Sec. S _____ T _____ R _____ SECTION

Compliance with
 ACT 345, P.A. 1990

APPROVED ON: 9-29-99 JK
 OAKLAND COUNTY REMONUMENTATION
 PEER GROUP COMMITTEE

Register of Deeds Stamp & File Num

4. Lot No. _____, Recorded Plat _____
 5. Private Claims _____

I, Grant J. Ward, R.L.S., in a field survey on June 18, 1998 do hereby state that under requirements of P.A. 74, Michigan P.A. of 1970, the corner points mentioned in lines 1 and 2 above were in conformance with regulations and rules therefore as required in the current manual of survey instructions of the United States Department of the Interior, Bureau of Land Management or by a decree of a Court of Law and /or that the corner points mentioned in lines 3, 4 and 5 above were in conformance with the rules of the Michigan Board of Land Surveyors or by a Decree of a Court of Law; established, re-established, monumented, recovered, found as expressed below.

NOTE: Not more than 2 corners, all in the same town and range, may be recorded on this certificate.

	A	B	C	D	E	F	G	H	I	J	K
1											
2		6		5		4		3		2	
3											
4		7		8		9		10		11	
5											
6		18		17		16		15		14	
7											
8		19		20		21		22		23	
9											
10		30		29		28		27		26	
11											
12		31		32		33		34		35	
13											

A. Description of original monument and accessories and/or subsequent restoration:

F-9 Post, per G.L.O. Notes.

B. Description of corner evidence found and/or method applied in restoring or reestablishing corner:


F-9 North 1/4 Corner of Section 28, T. 2 N., R. 7 E. Found 1/2" Iron Pipe.
 Previously Recorded in L. 12129 P. 044 (4) of Oakland County Records.

(n) Indicates the number of references that confirms this corner by dimensional tie.

This corner location is accepted by the contractor and is generally accepted by professional surveyors as the best available evidence of the position of the original corner.

C. Description of monument for corner and accessories established to perpetuate locating the position of the corner:

- F-9 Set Monument and Remonumentation Cap.
- N 70° E 11.75' Set MAG Nail & Remonumentation Disc in Northwest face of 10" Poplar.
- S 40° E 29.38' Set MAG Nail & Remonumentation Disc in Southwest face of 10" Maple.
- S 25° W 14.78' Set MAG Nail & Remonumentation Disc in Southeast face of 10" Poplar.
- N 45° W 12.19' Set MAG Nail & Remonumentation Disc in Southwest face of 12" Poplar.

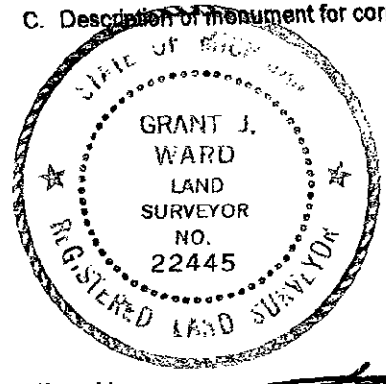

Signed by [Signature]
 Surveyor's Michigan License No. 22445

Date July 12, 1999

SEPTEMBER 19, 1999

Corner Code: F-9

DOSSIER FOR: THE SOUTH 1/4 CORNER OF SECTION 21, MILFORD TOWNSHIP,
T 2 N, R 7 E, OAKLAND COUNTY, MICHIGAN. Prepared under contract with the
County of Oakland Under Act 345 of the Public Acts of 1990.

HISTORY:

The Corner we found has been used since before 1945 as evidenced by an unrecorded survey for the Huron-Clinton Metropolitan Authority (HCMA) and was witnessed and recorded under Act 74 of the Public Acts of 1970 in Liber 12129, Page 044, by Robert D. Kohn, Surveyor.

COLLATERAL EVIDENCE:

We set a concrete monument and remonumentation cap in place of a 1/2" iron pipe we found 9 feet South of old Buno Road (overgrown) and 70 feet South of the South edge of a wetland. We measured 0.36 feet and 0.16 feet less than the recorded distances from the HCMA survey to the Southwest and the Southeast Corners of Section 21. We searched at least 50 feet in each direction for other stakes and found none that might represent the Corner.

SURVEYOR'S RECOMMENDATIONS:

This corner location is accepted by the Contractor and is generally accepted by Professional Surveyors as the best available evidence of the position of the original Corner. Therefore, I recommend that the Peer Review Group accept this Corner as monumented, with the references as shown on the enclosed form prepared according to Act 74 of the Public Acts of 1970.

Grant J. Ward, R.L.S.
License No. 22445

SURVEY &
REMONUMENTATION

MAR 21 2000

SECTION