

SURVEY & REMONUMENTATION
 MAY 24 2000
 1111 Ford

LIBER 21143 065

LAND CORNER RECORDATION CERTIFICATE
 Filing Requirement of Act 74, Mich. P.A. 1970

58661

LIBER 21143 PAGE 65
 \$9.00 MISC RECORDING
 \$2.00 REMONUMENTATION
 02/28/2000 01:52:10 P.M. RECEIPT# 16297
 PAID RECORDED - OAKLAND COUNTY
 G. WILLIAM CABELL, CLERK/REGISTER OF DEED

SECTION
 in Corners in

Oakland _____ (County)	Located In:	Corner Code #
1. Public Land Survey	T <u>2</u> N R <u>7</u> E	<u>F-13</u>
	T _____ R _____	_____
	T _____ R _____	_____
	T _____ R _____	_____
2. Property Controlling in Section	S _____ T _____ R _____	_____
	S _____ T _____ R _____	_____
3. Miscellaneous Property in Sec.	S _____ T _____ R _____	_____
	S _____ T _____ R _____	_____

Compliance with
 ACT 348, P.A. 1990

FILED ON: 12-7-99 JIL
 OAKLAND COUNTY REMONUMENTATION
 COMMITTEE

Register of Deeds Stamp & File Number

4. Lot No. _____, Recorded Plat _____
 5. Private Claims _____

A	B	C	D	E	F	G	H	I	J	K	L
1											
2	6		5		4		3		2		1
3											
4	7		8		9		10		11		12
5											
6	10		17		16		15		14		13
7											
8	19		20		21		22		23		24
9											
10	30		29		28		27		26		25
11											
12	31		32		33		34		35		36
13											

I, Grant J. Ward, R.L.S., in a field survey on December 4, 1999 do hereby state that under requirements of P.A. 74, Michigan P.A. of 1970, the corner points mentioned in lines 1 and 2 above were in conformance with regulations and rules therefore as required in the current manual of survey instructions of the United States Department of the Interior, Bureau of Land Management or by a decree of a Court of Law and/or that the corner points mentioned in lines 3, 4 and 5 above were in conformance with the rules of the Michigan Board of Land Surveyors or by a Decree of a Court of Law; established, re-established, monumented, recovered, found as expressed below:

NOTE: Not more than 2 corners, all in the same town and range, may be recorded on this certificate.

A. Description of original monument and accessories and/or subsequent restoration:
 F-13 Post, per G.L.O. Notes.

B. Description of corner evidence found and/or method applied in restoring or reestablishing corner:

F-13 South 1/4 Corner of Section 33, T. 2 N., R. 7 E. Nothing Found.


Previously unrecorded.

This corner location is accepted by the contractor and is generally accepted by professional surveyors as the best available evidence of the position of the original corner.

2P
R

C. Description of monument for corner and accessories established to perpetuate locating the position of the corner:

- F-13 Set a 5/8" Iron Rod and Remonumentation Cap in a New Monument Box.
- N 10° E 34.92' Set 60d Nail & Remonumentation Disc in East face of 8" Hickory.
- N 50° W 106.25' Set 60d Nail & Remonumentation Disc in Southwest face of 18" Oak.
- N 30° W 70.24' Set 60d Nail & Remonumentation Disc in Northeast face of 20" Oak.
- N 10° W 60.89' Set 60d Nail & Remonumentation Disc in West face of 20" Oak.

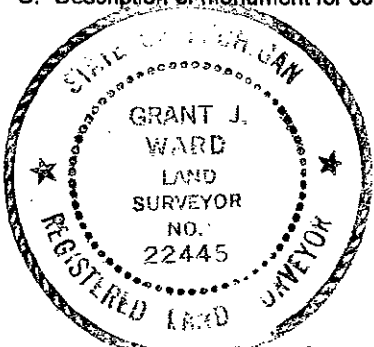

Signed by _____
 Surveyor's Michigan License No. 22445

Date December 8, 1999