

LAND CORNER RECORDATION CERTIFICATE 25886

Filing Requirement of Act 74, Mich. P.A. 1970 21028 PAGE 545

For corners in

Oakland (County)

Located in:

Corner Code #

1. Public Land Survey

T2N R 7E G-2

T R

T R

T R

2. Property Controlling In Section

S T R SURVEY & REMONUMENTATION

3. Miscellaneous Property in Sec.

S T R

S T R

MAR 21 2000

\$9.00 MISC RECORDING \$2.00 REMONUMENTATION 01/27/2000 08:21:22 A.M. RECEIPT# 6667 PAID RECORDED - OAKLAND COUNTY G. WILLIAM CADDELL, CLERK/REGISTER OF DEEDS

Compliance with ACT 345, P.A. 1990

APPROVED ON: 7-21-99 JZ OAKLAND COUNTY REMONUMENTATION PEER GROUP COMMITTEE

Register of Deeds Stamp & File Number

4. Lot No. , Recorded Plat SECTION

5. Private Claims

I, Grant J. Ward, R.L.S., in a field survey on December 10, 19 98 do hereby state that under requirements of P.A. 74, Michigan P.A. of 1970, the corner points mentioned in lines 1 and 2 above were in conformance with regulations and rules therefore as required in the current manual of survey instructions of the United States Department of the Interior, Bureau of Land Management or by a decree of a Court of Law and /or that the corner points mentioned in lines 3, 4 and 5 above were in conformance with the rules of the Michigan Board of Land Surveyors or by a Decree of a Court of Law; established, re-established, monumented, recovered, found as expressed below.

NOTE: Not more than 2 corners, all in the same town and range, may be recorded on this certificate.

Grid table with columns A-L and rows 1-13. A dot is present at the intersection of column G and row 2.

A. Description of original monument and accessories and/or subsequent restoration:

G-2 Post, per G.L.O. Notes.

B. Description of corner evidence found and/or method applied in restoring or reestablishing corner:

G-2 East 1/4 Corner of Section 4, T. 2 N., R. 7 E. Found 1/2" Iron Pipe.


Previously Recorded in L. 7564 P. 229 (1) of Oakland County Records.

(n) Indicates the number of references that confirms this corner by dimensional tie.

This corner location is accepted by the contractor and is generally accepted by professional surveyors as the best available evidence of the position of the original corner.

C. Description of monument for corner and accessories established to perpetuate locating the position of the corner:

- G-2 Set Monument and Remonumentation Cap. North 5.07' Set 60d Nail & Remonumentation Disc in West face of 8" Sassafrass S 30° E 18.38' Set 60d Nail & Remonumentation Disc in East face of 8" Hickory. S 50° W 5.07' Set 60d Nail & Remonumentation Disc in Southeast face of 6" Sassafrass. N 70° W 9.90' Set 60d Nail & Remonumentation Disc in Northwest face of 14" Sassafrass.

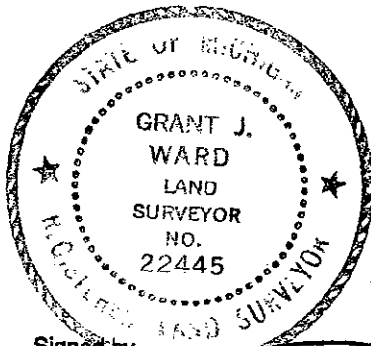

Signed by [Signature] Surveyor's Michigan License No. 22445

Date July 12, 1999

JULY 3, 1999

Corner Code: G-2

DOSSIER FOR: THE EAST 1/4 CORNER OF SECTION 4, MILFORD TOWNSHIP, T 2 N, R 7 E, OAKLAND COUNTY, MICHIGAN. Prepared under contract with the County of Oakland Under Act 345 of the Public Acts of 1990.

HISTORY:

This Corner has been accepted and used since before 1979, as evidenced by recordings under Act 74 of the Public Acts of 1970, by James G. Campbell, Surveyor as recorded in Liber 7564, Page 229.

COLLATERAL EVIDENCE:

We found a 1/2" pipe and set a concrete monument with remonumentation cap on top. This Corner lies on a fallen fence line. There is a tree row running East and a gas line marker 31.1 feet East of the Corner. We searched at least 50 feet in each direction for other stakes and found none that might represent the Corner. The distance we measured to the Northwest Corner of Section 3 is 0.44 feet longer than the record. All of the Act 132 Surveys in the dossiers use this same Corner.

SURVEYOR'S RECOMMENDATIONS:

This corner location is accepted by the Contractor and is generally accepted by Professional Surveyors as the best available evidence of the position of the original Corner. Therefore, I recommend that the Peer Review Group accept this Corner as monumented, with the references as shown on the enclosed form prepared according to Act 74 of the Public Acts of 1970.

Grant J. Ward, R.L.S.
License No. 22445

SURVEY &
REMONUMENTATION

MAR 21 2000

SECTION