

LIBER 21028 PAGE 553
Wulford

25890

LAND CORNER RECORDATION CERTIFICATE
 Filing Requirement of Act 74, Mich. P.A. 1970

LIBER 21028 PAGE 553
 \$9.00 MISC RECORDING
 \$2.00 REMONUMENTATION
 01/27/2000 08:21:22 A.M. RECEIPT# 66
 PAID RECORDED - OAKLAND COUNTY
 G. WILLIAM CADDELL, CLERK/REGISTER OF

For corners in

Oakland
 (County)

Located In:

Corner Code #

1. Public Land Survey

T2N R 7E

G-6

T R

T R

T R

T R

2. Property Controlling in Section

S

T R

S

T R

3. Miscellaneous Property in Sec.

S

T R

S

T R

SURVEY &
 REMONUMENTATION

MAR 21 2000

Compliance with
 ACT 345, P.A. 1990
 APPROVED ON: 7-19-99 JL
 OAKLAND COUNTY REMONUMENTATION
 PEER GROUP COMMITTEE
 Register of Deeds Stamp & File Number

4. Lot No. _____, Recorded Plat _____

5. Private Claims _____

SECTION

I, Grant J. Ward, R.L.S., in a field survey on May 17, 1999 do hereby state that under requirements of P.A. 74, Michigan P.A. of 1970, the corner points mentioned in lines 1 and 2 above were in conformance with regulations and rules therefore as required in the current manual of survey instructions of the United States Department of the Interior, Bureau of Land Management or by a decree of a Court of Law and /or that the corner points mentioned in lines 3, 4 and 5 above were in conformance with the rules of the Michigan Board of Land Surveyors or by a Decree of a Court of Law; established, re-established, monumented, recovered, found as expressed below:

NOTE: Not more than 2 corners, all in the same town and range, may be recorded on this certificate.

	A	B	C	D	E	F	G	H	I	J	K
1											
2	6		5			4		3		2	
3											
4	7		8			9		10		11	1
5											
6	18		17			16	●	15		14	1
7											
8	19		20			21		22		23	2
9											
10	30		29			28		27		26	2
11											
12	31		32			33		34		35	3
13											

A. Description of original monument and accessories and/or subsequent restoration:

G-6 Post, per G.L.O. Notes.

B. Description of corner evidence found and/or method applied in restoring or reestablishing corner:


G-6 East 1/4 Corner of Section 16, T. 2 N., R. 7 E. Found Monument.

Previously Recorded in L. 10272 P. 293 (3) of Oakland County Records.

(n) Indicates the number of references that confirms this corner by dimensional tie.

This corner location of a corner, although not established by an original government survey, is established as the best available evidence of the position of the corner.

C. Description of monument for corner and accessories established to perpetuate locating the position of the corner:

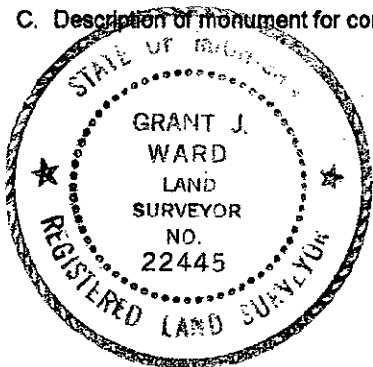

- G-6 Capped Existing Monument.
- North 3.90' Set 60d Nail & Remonumentation Disc in East face of 28" Oak.
- N 80° E 42.75' Set 60d Nail & Remonumentation Disc in Northwest face of Twin 12" Cherries.
- N 60° W 17.82' Set 60d Nail & Remonumentation Disc in North face of 28" Oak.
- N 55° W 28.26' Set 60d Nail & Remonumentation Disc in North face of 28" Oak.

Signed by [Signature]

Date July 12, 1999

Surveyor's Michigan License No. 22445

JULY 3, 1999

Corner Code: G-6

DOSSIER FOR: THE WEST 1/4 CORNER OF SECTION 15, MILFORD TOWNSHIP, T 2 N, R 7 E, OAKLAND COUNTY, MICHIGAN. Prepared under contract with the County of Oakland Under Act 345 of the Public Acts of 1990.

HISTORY:

This Corner has been accepted and used since before 1988, as evidenced by the Corner being recorded under Act 74 of the Public Acts of 1970 in Liber 10272, Page 293, by John R. Fenn, R.L.S.

COLLATERAL EVIDENCE:

We set a remonumentation cap on the concrete monument we found at the Corner. There is a fence line running West and South from the Corner. We searched at least 50 feet in each direction for other stakes and found none that might represent the Corner. The measured distance to the Northwest Corner of Section 15 agrees with the recorded dimension within 0.08 feet.

SURVEYOR'S RECOMMENDATIONS:

This corner location is accepted by the Contractor and is generally accepted by Professional Surveyors as the best available evidence of the position of the original Corner. Therefore, I recommend that the Peer Review Group accept this Corner as monumented, with the references as shown on the enclosed form prepared according to Act 74 of the Public Acts of 1970.

Grant J. Ward, R.L.S.
License No. 22445

SURVEY &
REMONUMENTATION

MAR 21 2000

SECTION