

SURVEY & REMONUMENTATION

LIBER 15772 PG 368

OCT 26 95 209874

MAY 16 1996

LAND CORNER RECORDATION CERTIFICATE
Filing Requirement of Act 74, Mich. P.A. 1970

Compliance with ACT 345, P.A. 1990

95-0102

For corners in

COMMISSION

Oakland

(County)

Located In:

Corner Code #

APPROVED ON: 10-2-95 TS
OAKLAND COUNTY REMONUMENTATION
PEER GROUP COMMITTEE

- | | | | | | |
|------------------------------------|---|----|---|----|------|
| 1. Public Land Survey | T | 2N | R | 7E | G-13 |
| | T | | R | | |
| | T | | R | | |
| | T | | R | | |
| 2. Property Controlling in Section | S | | T | R | |
| | S | | T | R | |
| 3. Miscellaneous Property in Sec. | S | | T | R | |
| | S | | T | R | |
4. Lot No. _____, Recorded Plat _____
5. Private Claims _____

\$ 9.00 MISCELLANEOUS RECORDING
\$ 2.00 REMONUMENTATION
26 OCT 95 7:20 A.M. RECEIPT# 2B
PAID RECORDED - OAKLAND COUNTY
LYNN D. ALLEN, CLERK/REGISTER OF DEEDS

Register of Deeds Stamp & File Number

Grant J. Ward, R.L.S.

I, in a field survey on September 25, 19 95, do hereby certify that under requirements of P.A. 74, Michigan P.A. of 1970, the corner points mentioned in lines 1 and 2 above were in conformance with regulations and rules therefore as required in the current manual of survey instructions of the United States Department of the Interior, Bureau of Land Management or by a decree of a Court of Law and/or that the corner points mentioned in lines 3, 4 and 5 above were in conformance with the rules of the Michigan Board of Land Surveyors or by a Decree of a Court of Law; established, re-established, monumented, re-monumented, recovered, found as expressed below:

NOTE: Not more than 4 corners, all in the same town and range, may be recorded on this certificate.

	A	B	C	D	E	F	G	H	I	J	K	L	M
2	6		5		4		3		2		1		
3													
4	7		8		9		10		11		12		
5													
6	18		17		16		15		14		13		
7													
8	19		20		21		22		23		24		
9													
10	30		29		28		27		26		25		
11													
12	31		32		33		34		35		36		
13													

A. Description of original monument and accessories and/or subsequent restoration:

G-13 Post, per G.L.O. Notes.

B. Description of corner evidence found and/or method applied in restoring or reestablishing corner:

G-13 Corner common to Sec. 33, 34 and the Town Line, T. 2 N., R. 7 E. This corner location is accepted by the contractor and is generally accepted by professional surveyors as the best available evidence of the position of the original corner.


Previously Recorded in L. 9628, P. 759 (0) of the Oakland County Records.

(n) Indicates the number of references that confirm this corner by dimensional tie.

C. Description of monument for corner and accessories established to perpetuate locating the position of the corner:

G-13 Corner common to Sec. 33, 34, and the Town Line, T. 2 N., R. 7 E. Set 5/8" Iron Rod and Brass Cap #22445 in Monument Box.

- N. 34° E. 115.44' Set P.K. Nail & Brass Disc #22445 in NW. face of Utility Pole.
- S. 37° E. 64.91' Set P.K. Nail & Brass Disc #22445 in NE. face of Utility Pole.
- S. 70° W. 95.96' Set P.K. Nail & Brass Disc #22445 in N. face of Utility Pole.
- N. 60° W. 71.58' Set P.K. Nail & Brass Disc #22445 in S. face of 4x4 Sign Post.
- Due West 245.66' Northwest Corner Section 3, Lyon Township.

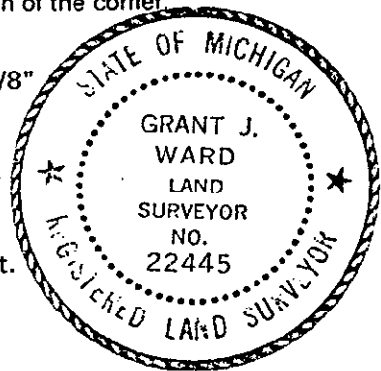

Signed by [Signature]

Date September 26, 1995

Surveyor's Michigan License No. 22445

9.00
2.00
Rmt

SEPTEMBER 29, 1995

Corner Code: G-13

DOSSIER FOR: THE SOUTHWEST CORNER OF SECTION 34, MILFORD TOWNSHIP, T 2 N, R 7 E, OAKLAND COUNTY, MICHIGAN. Prepared under contract with the County of Oakland Under Act 345 of the Public Acts of 1990.

HISTORY:

The South Boundary of this Township was originally surveyed by Alex Holmes, Deputy Surveyor, in 1816.

SPECIAL NOTES:

After reviewing the transcripts of the Original GLO Notes, I believe that the original survey lines were run as documented and that the dimensions seem to be accurate in the Southeast 1/4 of this Township, with our measurements agreeing within 10 to 15 feet, in practically all instances.

This Corner has been accepted and used since before 1986, as evidenced by recordings under Act 74 of the Public Acts of 1970.

COLLATERAL EVIDENCE:

We set this Corner from the MDOT distances from the West 1/4 Corner of Section 34 and the Northwest Corner of Section 3 of Lyon Township. The GLO calls for this Corner to lie 258.72 feet East of the Lyon Township Corner (MDOT calls for 245.66 feet).

We searched at least 50 feet in each direction for other stakes and found none that might represent the Corner.

The measured dimensions to the West 1/4 Corner of Section 34 agree with the dimensions taken from recorded surveys, the most recent tax maps and/or other old surveys within one tenth of a foot.

This Corner was first recorded in 1986 by Philip H. Wetoskey in Liber 9628, Page 759, of the Oakland County Records.

SURVEYOR'S RECOMMENDATIONS:

Therefore, I recommend that the Peer Review Group accept this Corner as monumented, with the references as shown on the enclosed form prepared according to Act 74 of the Public Acts of 1970.

Grant J. Ward, R.L.S.
License No. 22445