

LAND CORNER RECORDATION CERTIFICATE  
Filing Requirement of Act 74, Mich. P.A. 1970

25895

LIBER 21028 PAGE 563  
\$9.00 MISC RECORDING  
\$2.00 REMONUMENTATION  
01/27/2000 08:21:22 A.M. RECEIPT# 6667  
PAID RECORDED - OAKLAND COUNTY  
G. WILLIAM CADDELL, CLERK/REGISTER OF DEEDS

For corners in

Oakland  
(County)

Located In:

Corner Code #

1. Public Land Survey

T2N R 7E H-7

T R

T R

T R

S T R

S T R

S T R

S T R

2. Property Controlling in Section

SURVEY & REMONUMENTATION

3. Miscellaneous Property in Sec.

MAR 21 2000

SECTION

4. Lot No. \_\_\_\_\_, Recorded Plat \_\_\_\_\_  
5. Private Claims \_\_\_\_\_

I, Grant J. Ward, R.L.S., in a field survey on June 22, 1999 do hereby state that under requirements of P.A. 74, Michigan P.A. of 1970, the corner points mentioned in lines 1 and 2 above were in conformance with regulations and rules therefore as required in the current manual of survey instructions of the United States Department of the Interior, Bureau of Land Management or by a decree of a Court of Law and /or that the corner points mentioned in lines 3, 4 and 5 above were in conformance with the rules of the Michigan Board of Land Surveyors or by a Decree of a Court of Law; established, re-established, monumented, recovered, found as expressed below.

NOTE: Not more than 2 corners, all in the same town and range, may be recorded on this certificate.

	A	B	C	D	E	F	G	H	I	J	K	L
1												
2		6		5		4		3		2		1
3												
4		7		8		9		10		11		12
5												
6		18		17		16		15		14		13
7												
8		19		20		21		22		23		24
9												
10		30		29		28		27		26		25
11												
12		31		32		33		34		35		36
13												

A. Description of original monument and accessories and/or subsequent restoration:

H-7 Post, per G.L.O. Notes.

B. Description of corner evidence found and/or method applied in restoring or reestablishing corner:

H-7 North 1/4 Corner of Section 22, T. 2 N., R. 7 E. Found Iron Rod and Cap #12584.


Previously recorded in L. 7455 P.850 (2) of Oakland County Records.

(n) Indicates the number of references that confirms this corner by dimensional tie.

This corner location is accepted by the contractor and is generally accepted by professional surveyors as the best available evidence of the position of the original corner.

C. Description of monument for corner and accessories established to perpetuate locating the position of the corner:

- H-7 Set Monument & Remonumentation Cap.
- N 05° E 20.70' Set PK Nail & Remonumentation Disc in West face of 16" Walnut.
- S 35° E 5.87' Set PK Nail & Remonumentation Disc in Southwest face of Twin 12" Walnut.
- S 15° E 14.86' Set PK Nail & Remonumentation Disc in West face of 16" Walnut.
- N 35° W 34.89' Set PK Nail & Remonumentation Disc in Northeast face of 26" Walnut.

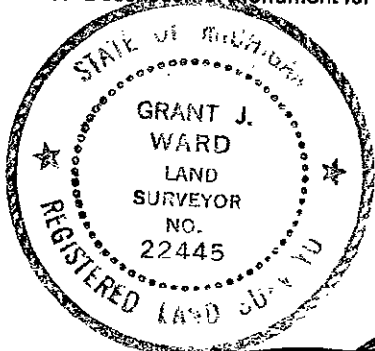

Signed by \_\_\_\_\_  
Surveyor's Michigan License No. 22445

Date July 12, 1999

JULY 3, 1999

Corner Code: H-7

DOSSIER FOR: THE SOUTH 1/4 CORNER OF SECTION 15, MILFORD TOWNSHIP,  
T 2 N, R 7 E, OAKLAND COUNTY, MICHIGAN. Prepared under contract with the  
County of Oakland Under Act 345 of the Public Acts of 1990.

**HISTORY:**

This Corner has been accepted and used since before 1935 as witnessed by the Road Commission for Oakland County at that time. It was recorded under Act 74 of the Public Acts of 1970 in Liber 7455, Page 850, by John D. Albright, Surveyor in 1979.

**COLLATERAL EVIDENCE:**

We set a concrete monument and remonumentation cap in place of a 1/2" iron rod and cap we found. There is a fence line running South and East from the Corner and a tree row running East and West. The tax maps indicate a distance of 3.22 feet more than our measurement to the Southwest Corner and 1.52 feet less than we measured to the Southeast Corner of Section 15.

We searched at least 50 feet in each direction for other stakes and found none that might represent the Corner.

**SURVEYOR'S RECOMMENDATIONS:**

This corner location is accepted by the Contractor and is generally accepted by Professional Surveyors as the best available evidence of the position of the original Corner. Therefore, I recommend that the Peer Review Group accept this Corner as monumented, with the references as shown on the enclosed form prepared according to Act 74 of the Public Acts of 1970.

---

Grant J. Ward, R.L.S.  
License No. 22445

SURVEY &  
REMONUMENTATION

MAR 21 2000

SECTION