

MAY 16 1996

LISER 15772 PG 370

OCT 26 95 209875

Compliance with ACT 345, P.A. 1990

COMMISSION

LAND CORNER RECORDATION CERTIFICATE

APPROVED ON: 10-2-95 TS OAKLAND COUNTY REMONUMENTATION PEER GROUP COMMITTEE

95-0102

Filing Requirement of Act 74, Mich. P.A. 1970

corners in Oakland (County)

Located In:

Corner Code #

- 1. Public Land Survey T 2N R 7E H-9
2. Property Controlling in Section S T R
3. Miscellaneous Property in Section S T R

\$ 9.00 MISCELLANEOUS RECORDING \$ 2.00 REMONUMENTATION 26 OCT 95 7:20 A.M. RECEIPT# 2B PAID RECORDED - OAKLAND COUNTY LYNN D. ALLEN, CLERK/REGISTER OF DEEDS

Register of Deeds Stamp & File Number

- 4. Lot No. , Recorded Plat
5. Private Claims

Grid table with columns A-M and rows 2-13. A dot is marked at the intersection of column G and row 9.

I, Grant J. Ward, R.L.S., in a field survey on February 10, 1995, do hereby certify that under requirements of P.A. 74, Michigan P.A. of 1970, the corner points mentioned in lines 1 and 2 above were in conformance with regulations and rules therefore as required in the current manual of survey instructions of the United States Department of the Interior, Bureau of Land Management or by a decree of a Court of Law and/or that the corner points mentioned in lines 3, 4 and 5 above were in conformance with the rules of the Michigan Board of Professional Surveyors or by a Decree of a Court of Law; established, re-established, monumented, re-monumented, recovered, found as expressed below:

NOTE: Not more than 4 corners, all in the same town and range, may be recorded on this certificate.

A. Description of original monument and accessories and/or subsequent restoration:

H-9 Post, per G.L.O. Notes.

B. Description of corner evidence found and/or method applied in restoring or reestablishing corner:

H-9 Corner common to Sec. 22 and 27, T. 2 N., R. 7 E. Found Iron Pipe in the Centerline of Buno Road. Pipe is 0.45' below Road surface. Tree row to the South. This corner location is accepted by the contractor and is generally accepted by professional surveyors as the best available evidence of the position of the original corner.


Previously Recorded in L. 7524, P. 754 (2) and L. 12129, P. 044 (4) of the Oakland County Records.

(n) Indicates the number of references that confirm this corner by dimensional tie.

C. Description of monument for corner and accessories established to perpetuate locating the position of the corner:

H-9 Corner common to Sec. 22 and 27, T. 2 N., R. 7 E. Set 5/8" Iron Rod and Brass Cap #22445.

- N. 50° E. 25.35' Set P.K. Nail & Brass Disc #22445 in SE. face of 18" Oak.
S. 55° E. 35.92' Set P.K. Nail & Brass Disc #22445 in NE. face of 10" Stump.
S. 60° W. 40.88' Set P.K. Nail & Brass Disc #22445 in NW. face of 10" Cherry.
N. 45° W. 28.71' Set P.K. Nail & Brass Disc #22445 in NE. face of 14" Oak.

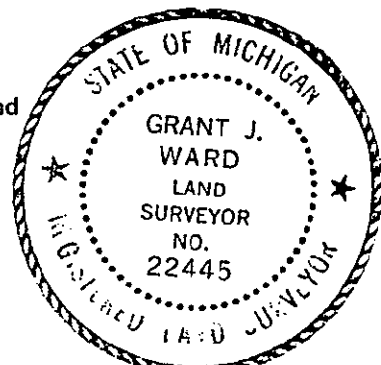

Signed by [Signature] Surveyor's Michigan License No. 22445

Date September 26, 1995

Handwritten note: 9.00 7.00 2/14/95

SEPTEMBER 19, 1995

Corner Code: H-9

DOSSIER FOR: THE SOUTH 1/4 CORNER OF SECTION 22, MILFORD TOWNSHIP, T 2 N, R 7 E, OAKLAND COUNTY, MICHIGAN. Prepared under contract with the County of Oakland Under Act 345 of the Public Acts of 1990.

HISTORY:

This Township was originally surveyed by Joseph Wampler, Deputy Surveyor, in 1823.

SPECIAL NOTES:

After reviewing the transcripts of the Original GLO Notes, I believe that the original survey lines were run as documented and that the dimensions seem to be accurate in the Southeast 1/4 of this Township, with our measurements agreeing within 10 to 15 feet, in practically all instances.

This Corner has been accepted and used since before 1979, as evidenced by recordings under Act 74 of the Public Acts of 1970.

COLLATERAL EVIDENCE:

We found an iron pipe in the Centerline of Buno Road on line with a tree row to the South. There is a tree row and fence line running East and West 23 feet South of this Corner. We found an iron rod 32.94 feet North of the Corner.

We searched at least 50 feet in each direction for other stakes and found none that might represent the Corner.

The measured dimensions to the Southwest and the Southeast Corners of Section 22 agree with the dimensions taken from recorded surveys, the most recent tax maps and/or other old surveys within one half of a foot.

This Corner was first recorded in 1979 by Huston K. Kennedy in Liber 7524, Page 754, of the Oakland County Records.

SURVEYOR'S RECOMMENDATIONS:

Therefore, I recommend that the Peer Review Group accept this Corner as monumented, with the references as shown on the enclosed form prepared according to Act 74 of the Public Acts of 1970.

Grant J. Ward, R.L.S.
License No. 22445