

Mulford

25896

LAND CORNER RECORDATION CERTIFICATE
Filing Requirement of Act 74, Mich. P.A. 1976

LIBER 21028 PAGE 565
\$2.00 MISC RECORDING
\$2.00 REMONUMENTATION
01/27/2000 08:21:22 A.M. RECEIPT# 6667
PAID RECORDED - OAKLAND COUNTY
G. WILLIAM CADDELL, CLERK/REGISTER OF DEED

For corners in

Oakland Located in: Corner Code #
(County)

- 1. Public Land Survey T2N R 7E I-1
T R
T R SURVEY &
T R REMONUMENTATION
 - 2. Property Controlling S T R
In Section S T R
 - 3. Miscellaneous S T R
Property in Sec. S T R
- MAR 21 2000
- SECTION

Compliance with
ACT 345, P.A. 1990

APPROVED ON: 7-28-99 - J/K
OAKLAND COUNTY REMONUMENTATION
PEER GROUP COMMITTEE
Register of Deeds Stamp & File Number

- 4. Lot No. _____, Recorded Plat _____
- 5. Private Claims _____

I, Grant J. Ward, R.L.S., in a field survey on June 30, 1999 do hereby state that under requirements of P.A. 74, Michigan P.A. of 1970, the corner points mentioned in lines 1 and 2 above were in conformance with regulations and rules therefore as required in the current manual of survey instructions of the United States Department of the Interior, Bureau of Land Management or by a decree of a Court of Law and /or that the corner points mentioned in lines 3, 4 and 5 above were in conformance with the rules of the Michigan Board of Land Surveyors or by a Decree of a Court of Law; established, re-established, monumented, recovered, found as expressed below:

NOTE: Not more than 2 corners, all in the same town and range, may be recorded on this certificate.

A	B	C	D	E	F	G	H	I	J	K	L
1											
2	6		5		4		3		2		1
3											
4	7		8		9		10		11		12
5											
6	18		17		16		15		14		13
7											
8	19		20		21		22		23		24
9											
10	30		29		28		27		26		25
11											
12	31		32		33		34		35		36
13											

A. Description of original monument and accessories and/or subsequent restoration:

I-1 Post, per G.L.O. Notes.

B. Description of corner evidence found and/or method applied in restoring or reestablishing corner:


I-1 Northeast Corner of Section 3, T. 2 N., R. 7 E.

Previously Unrecorded.

This corner location is a careful and faithful reestablishment of the position of the Original Corner.

2P
R

C. Description of monument for corner and accessories established to perpetuate locating the position of the corner:

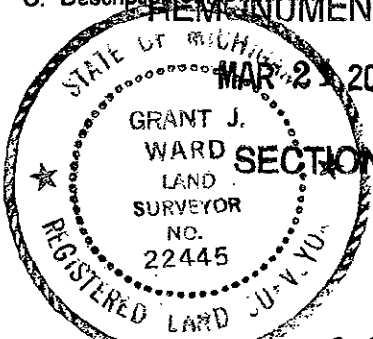

- Set Monument and Brass Remonumentation Cap at recorded GLO distance from I-13 on line with H-13 of Highland Township.
- S 20° E 14.18' Set 60d Nail & Remonumentation Disc in West face of 4" Ash.
- S 20° W 11.26' Set 60d Nail & Remonumentation Disc in West face of 12" Oak.
- S 50° W 5.87' Set 60d Nail & Remonumentation Disc in Northwest face of 20" Oak.
- N 40° W 10.47' Set 60d Nail & Remonumentation Disc in West face of 12" Oak.
- East 190.74' Found Southeast corner of Section 34 (I-13) of T. 3 N., R. 7 E. (Highland).

Signed by _____
Surveyor's Michigan License No. 22445

Date July 13, 1999

JULY 3, 1999

Corner Code: I-1

DOSSIER FOR: THE NORTHEAST CORNER OF SECTION 3, MILFORD TOWNSHIP,
T 2 N, R 7 E, OAKLAND COUNTY, MICHIGAN. Prepared under contract with the
County of Oakland Under Act 345 of the Public Acts of 1990.

HISTORY:

This Corner has not been witnessed or recorded previously. There is no recorded distance in the dossiers except the original GLO ties to adjacent Corners.

COLLATERAL EVIDENCE:

We set a concrete monument and remonumentation cap on the Township line between H-13 and I-13 of Highland Township 190.74 feet Westerly of I-13, which is the record falling from the GLO. There is no evidence of occupation in the vicinity of the Corner nor any recorded distances to the adjacent Corners. We searched at least 50 feet in each direction for other stakes and found none that might represent the Corner.

SURVEYOR'S RECOMMENDATIONS:

This Corner location is a careful and faithful re-establishment of the position of the Original Corner per the Government Instructions for an Obliterated Corner. Therefore, I recommend that the Peer Review Group accept this Corner as monumented, with the references as shown on the enclosed form prepared according to Act 74 of the Public Acts of 1970.

Grant J. Ward, R.L.S.
License No. 22445

SURVEY &
REMONUMENTATION

MAR 21 2000

SECTION