

Milford

LAND CORNER RECORDATION CERTIFICATE
Filing Requirement of Act 74, Mich. P.A. 1970

25901

For corners in

Oakland
(County)

Located in:

Corner Code #

1. Public Land Survey

T2N R 7E I-6

2. Property Controlling
in Section

S

T R

3. Miscellaneous
Property in Sec.

S

T R

S

T R

SURVEY &
REMONUMENTATION

MAR 21 2000

LIBER 21028 PAGE 575
\$9.00 MISC RECORDING
\$2.00 REMONUMENTATION
01/27/2000 08:21:22 A.M. RECEIPT# 6667
PAID RECORDED - OAKLAND COUNTY
S. WILLIAM CADDELL, CLERK/REGISTER OF DEEDS

Compliance with
ACT 345, P.A. 1990

APPROVED ON: 7-14-99 J/L
OAKLAND COUNTY REMONUMENTATION
PEER GROUP COMMITTEE

Register of Deeds Stamp & File Number

4. Lot No. _____ Recorded Plat _____ SECTION _____

5. Private Claims _____

I, Grant J. Ward, R.L.S., in a field survey on February 26, 1999 do hereby state that under requirements of P.A. 74, Michigan P.A. of 1970, the corner points mentioned in lines 1 and 2 above were in conformance with regulations and rules therefore as required in the current manual of survey instructions of the United States Department of the Interior, Bureau of Land Management or by a decree of a Court of Law and for that the corner points mentioned in lines 3, 4 and 5 above were in conformance with the rules of the Michigan Board of Land Surveyors or by a Decree of a Court of Law, established, re-established, monumented, recovered, found as expressed below:

NOTE: Not more than 2 corners, all in the same town and range, may be recorded on this certificate.

	A	B	C	D	E	F	G	H	I	J	K	L
1												
2		6		5		4		3		2		1
3												
4		7		8		9		10		11		12
5												
6		18		17		16		15	●	14		13
7												
8		19		20		21		22		23		24
9												
10		30		29		28		27		26		25
11												
12		31		32		33		34		35		36
13												

A. Description of original monument and accessories and/or subsequent restoration:

I-6 Post, per G.L.O. Notes.

B. Description of corner evidence found and/or method applied in restoring or reestablishing corner:

I-6 East 1/4 Corner of Section 15, T. 2 N., R. 7 E. Found 1/2" Iron Rod.

Previously Recorded in L. 6248 P. 372 (3) and L. 10272 P. 294 (3) of Oakland County Records.


(n) Indicates the number of references that confirms this corner by dimensional tie.

This corner location is accepted by the contractor and is generally accepted by professional surveyors as the best available evidence of the position of the original corner.

2P
R

C. Description of monument for corner and accessories established to perpetuate locating the position of the corner:

- I-6 Set 5/8" Iron Rod and Brass Remonumentation Cap.
- N 45° E 29.97' Set 60d Nail & Remonumentation Disc in South face of 12" Hickory.
- N 75° E 20.77' Set 60d Nail & Remonumentation Disc in North face of 10" Hickory.
- S 50° W 25.22' Set 60d Nail & Remonumentation Disc in Southeast face of Twin 14"&16" Oaks.
- N 50° W 28.76' Set 60d Nail & Remonumentation Disc in Northeast face of 18" Oak.

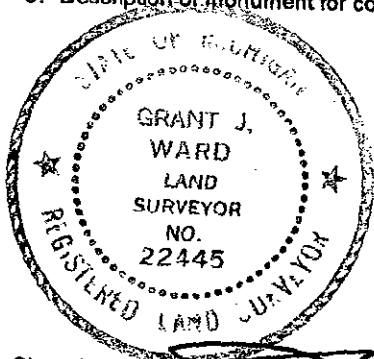

Signed by _____
Surveyor's Michigan License No. 22445

Date July 12, 1999

JULY 3, 1999

Corner Code: I-6

DOSSIER FOR: THE EAST 1/4 CORNER OF SECTION 15, MILFORD TOWNSHIP, T 2 N, R 7 E, OAKLAND COUNTY, MICHIGAN. Prepared under contract with the County of Oakland Under Act 345 of the Public Acts of 1990.

HISTORY:

This Corner has been accepted and used since before 1973, as evidenced by an unrecorded survey by Oscar Boss and then recorded under Act 74 of the Public Acts of 1970 in 1974 by Oscar Boss, Surveyor, in Liber 6248, Page 372.

COLLATERAL EVIDENCE:

We set a 5/8" iron rod and remonumentation cap in place of a 1/2" rod in the Centerline of South Hill Road. There is a tree row and fence line running to the East. We measured 0.11 feet and 0.07 feet less than the recorded distance to the Northwest and the Southwest Corners, respectively of Section 14.

We searched at least 50 feet in each direction for other stakes and found none that might represent the Corner.

SURVEYOR'S RECOMMENDATIONS:

This corner location is accepted by the Contractor and is generally accepted by Professional Surveyors as the best available evidence of the position of the original Corner. Therefore, I recommend that the Peer Review Group accept this Corner as monumented, with the references as shown on the enclosed form prepared according to Act 74 of the Public Acts of 1970.

Grant J. Ward, R.L.S.
License No. 22445

SURVEY &
REMONUMENTATION

MAR 21 2000

SECTION