

MAY 16 1995
MAY 16 1995

Oct 26 95 209878

COMMISSION

LAND CORNER RECORDATION CERTIFICATE
Filing Requirement of Act 74, Mich. P.A. 1970

15772-376

Compliance with
ACT 345, P.A. 1990

APPROVED ON: 10-2-95 JS
OAKLAND COUNTY REMONUMENTATION
PRER GROUP COMMITTEE

95-0102

For corners in
Oakland
(County)

Located In:

Corner Code #

- 1. Public Land Survey T 2N R 7E I-8
- T _____ R _____
- T _____ R _____
- T _____ R _____
- 2. Property Controlling S _____ T _____ R _____
- In Section S _____ T _____ R _____
- 3. Miscellaneous S _____ T _____ R _____
- Property in Section S _____ T _____ R _____

\$ 9.00 MISCELLANEOUS RECORDING
\$ 2.00 REMONUMENTATION
26 OCT 95 7:21 A.M. RECEIPT# 2B
PAID RECORDED - OAKLAND COUNTY
LYNN D. ALLEN, CLERK/REGISTER OF DEEDS

Register of Deeds Stamp & File Number

- 4. Lot No. _____, Recorded Plat _____
- 5. Private Claims _____

	A	B	C	D	E	F	G	H	I	J	K	L	M
2	6		5		4		3		2		1		
3													
4	7		8		9		10		11		12		
5													
6	18		17		16		15		14		13		
7													
8	19		20		21		22		23		24		
9													
10	30		29		28		27		26		25		
11													
12	31		32		33		34		35		36		
13													

Grant J. Ward, R.L.S.

I, _____, in a field survey on February 10, 19 95, do hereby certify that under requirements of P.A. 74, Michigan P.A. of 1970, the corner points mentioned in lines 1 and 2 above were in conformance with regulations and rules therefore as required in the current manual of survey instructions of the United States Department of the Interior, Bureau of Land Management or by a decree of a Court of Law and/or that the corner points mentioned in lines 3, 4 and 5 above were in conformance with the rules of the Michigan Board of Professional Surveyors or by a Decree of a Court of Law; established, re-established, monumented, re-monumented, recovered, found as expressed below:

NOTE: Not more than 4 corners, all in the same town and range, may be recorded on this certificate.

A. Description of original monument and accessories and/or subsequent restoration:

I-8 Post, per G.L.O. Notes.

B. Description of corner evidence found and/or method applied in restoring or reestablishing corner:

I-8 Corner common to Sec. 22 and 23, T. 2 N., R. 7 E. Found Iron Pipe at the South base of a twin 14" Cherry, 0.3' above surface. Pipe lines up with South Hill Road to the South. This corner location is accepted by the contractor and is generally accepted by professional surveyors as the best available evidence of the position of the original corner.


Previously Recorded in L. 10434, P. 807 (4); L. 11545, P. 140 (3) and L. 15176 P. 197 (4) of the Oakland County Records.

(n) Indicates the number of references that confirm this corner by dimensional tie.

C. Description of monument for corner and accessories established to perpetuate locating the position of the corner:

I-8 Corner common to Sec. 22 and 23, T. 2 N., R. 7 E. Set 5/8" Iron Rod and Brass Cap #22445.

- N. 80° E. 0.65' Set P.K. Nail & Brass Disc #22445 in S. face of twin 14" Cherry.
- S. 50° E. 30.70' Set P.K. Nail & Brass Disc #22445 in S. face of 6" Pine.
- S. 40° W. 19.84' Set P.K. Nail & Brass Disc #22445 in NW. face of 10" Elm.
- S. 70° W. 20.74' Set P.K. Nail & Brass Disc #22445 in NW. face of 10" Oak.

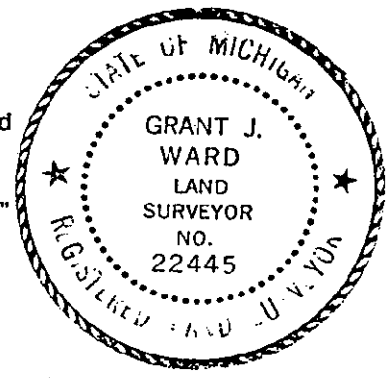

Signed by _____

Date September 26, 1995

Surveyor's Michigan License No. 22445

9.00
2.00
Rmt

SEPTEMBER 19, 1995

Corner Code: I-8

DOSSIER FOR: THE EAST 1/4 CORNER OF SECTION 22, MILFORD TOWNSHIP, T 2 N, R 7 E, OAKLAND COUNTY, MICHIGAN. Prepared under contract with the County of Oakland Under Act 345 of the Public Acts of 1990.

HISTORY:

This Township was originally surveyed by Joseph Wampler, Deputy Surveyor, in 1823.

SPECIAL NOTES:

After reviewing the transcripts of the Original GLO Notes, I believe that the original survey lines were run as documented and that the dimensions seem to be accurate in the Southeast 1/4 of this Township, with our measurements agreeing within 10 to 15 feet, in practically all instances.

This Corner has been accepted and used since before 1988, as evidenced by recordings under Act 74 of the Public Acts of 1970.

COLLATERAL EVIDENCE:

We found an iron pipe at the base of a twin 14" Wild Cherry, on line with the Centerline of South Hill Road to the South. There is a tree row running East and West.

We searched at least 50 feet in each direction for other stakes and found none that might represent the Corner.

The measured dimension to the Southeast Corner of Section 22 agrees with the dimensions taken from recorded surveys, the most recent tax maps and/or other old surveys within one half of a foot.

This Corner was first recorded in 1988 by John R. Fenn in Liber 10434, Page 807, of the Oakland County Records.

SURVEYOR'S RECOMMENDATIONS:

Therefore, I recommend that the Peer Review Group accept this Corner as monumented, with the references as shown on the enclosed form prepared according to Act 74 of the Public Acts of 1970.

Grant J. Ward, R.L.S.
License No. 22445