

**SURVEY & REMONUMENTATION**

LIBER 15772 PG 398

Oct 26 95 209889

Compliance with ACT 345, P.A. 1990

MAY 16 1996

**LAND CORNER RECORDATION CERTIFICATE**

Filing Requirement of Act 74, Mich. P.A. 1970

APPROVED ON: 10-9-95 TS

OAKLAND COUNTY REMONUMENTATION PEER GROUP COMMITTEE

95-0102  
For corners in Oakland

**COMMISSION**

Located In:

Corner Code #

- |                                      |   |    |   |    |      |
|--------------------------------------|---|----|---|----|------|
| 1. Public Land Survey                | T | 2N | R | 7E | K-12 |
|                                      | T |    | R |    |      |
|                                      | T |    | R |    |      |
|                                      | T |    | R |    |      |
| 2. Property Controlling in Section   | S |    | T | R  |      |
|                                      | S |    | T | R  |      |
| 3. Miscellaneous Property in Section | S |    | T | R  |      |
|                                      | S |    | T | R  |      |
4. Lot No. \_\_\_\_\_, Recorded Plat \_\_\_\_\_
5. Private Claims \_\_\_\_\_

\$ 9.00 MISCELLANEOUS RECORDING  
\$ 2.00 REMONUMENTATION  
26 OCT 95 7:22 A.M. RECEIPT# 2B  
PAID RECORDED - OAKLAND COUNTY  
LYNN D. ALLEN, CLERK/REGISTER OF DEEDS

Register of Deeds Stamp & File Number

	A	B	C	D	E	F	G	H	I	J	K	L	M
2	6		5		4		3		2				
3													
4	7		8		9		10		11		12		
5													
6	18		17		16		15		14		13		
7													
8	19		20		21		22		23		24		
9													
10	30		29		28		27		26		25		
11													
12	31		32		33		34		35		36		
13													

Grant J. Ward, R.L.S.

I, \_\_\_\_\_, in a field survey on February 10, 1995, do hereby certify that under requirements of P.A. 74, Michigan P.A. of 1970, the corner points mentioned in lines 1 and 2 above were in conformance with regulations and rules therefore as required in the current manual of survey instructions of the United States Department of the Interior, Bureau of Land Management or by a decree of a Court of Law and/or that the corner points mentioned in lines 3, 4 and 5 above were in conformance with the rules of the Michigan Board of Professional Surveyors or by a Decree of a Court of Law; established, re-established, monumented, re-monumented, recovered, found as expressed below:

**NOTE: Not more than 4 corners, all in the same town and range, may be recorded on this certificate.**

**A. Description of original monument and accessories and/or subsequent restoration:**

K-12 Post, per G.L.O. Notes.

**B. Description of corner evidence found and/or method applied in restoring or reestablishing corner:**


K-12 Corner common to Sec. 35 and 36, T. 2 N., R. 7 E. Found Iron Rod in Monument Box in the Center-line of Old Plank Road, 0.65' below Road surface. Corner is in line with the North edge of East Moore Road to the West. Fence line to the East. This corner location is accepted by the contractor and is generally accepted by professional surveyors as the best available evidence of the position of the original corner.

Previously Recorded in L. 9262, P. 185 (2) of the Oakland County Records.

**C. Description of monument for corner and accessories established to perpetuate locating the position of the corner:**

K-12 Corner common to Sec. 35 and 36, T. 2 N., R. 7 E. Set 5/8" Iron Rod and Brass Cap #22445 in Existing Monument Box.

- N. 60° E. 69.43' Set P.K. Nail & Brass Disc #22445 in top of fence post.
- N. 75° E. 36.13' Set P.K. Nail & Brass Disc #22445 in N. face of Utility Pole.
- S. 65° W. 49.82' Set P.K. Nail & Brass Disc #22445 in NW. face of Utility Pole.
- S. 65° W. 57.64' Set P.K. Nail & Brass Disc #22445 in N. face of 16" Cherry.

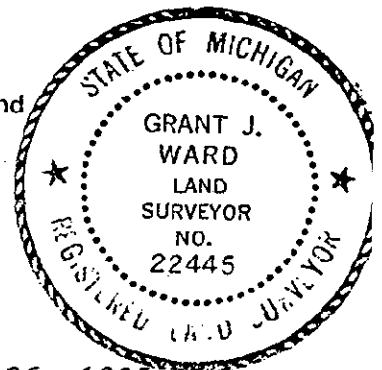

Signed by [Signature]

Date September 26, 1995

Surveyor's Michigan License No. 22445

9.00  
2.00  
Rmt

SEPTEMBER 19, 1995

Corner Code: K-12

DOSSIER FOR: THE EAST 1/4 CORNER OF SECTION 35, MILFORD TOWNSHIP, T 2 N, R 7 E, OAKLAND COUNTY, MICHIGAN. Prepared under contract with the County of Oakland Under Act 345 of the Public Acts of 1990.

**HISTORY:**

This Township was originally surveyed by Joseph Wampler, Deputy Surveyor, in 1823.

**SPECIAL NOTES:**

After reviewing the transcripts of the Original GLO Notes, I believe that the original survey lines were run as documented and that the dimensions seem to be accurate in the Southeast 1/4 of this Township, with our measurements agreeing within 10 to 15 feet, in practically all instances.

This Corner has been accepted and used since before 1984, as evidenced by recordings under Act 74 of the Public Acts of 1970.

**COLLATERAL EVIDENCE:**

We found an iron rod in a Monument Box at the intersection of the Centerline of Old Plank Road and a fence line to the East. There is also a fence line running North 57 feet East of the Corner.

We searched at least 50 feet in each direction for other stakes and found none that might represent the Corner.

The measured dimensions to the Northeast and the Southeast Corners of Section 35 agree with the dimensions taken from recorded surveys, the most recent tax maps and/or other old surveys within one half of a foot.

This Corner was first recorded in 1986 by Robert M. Pitts in Liber 9262, Page 185, of the Oakland County Records.

**SURVEYOR'S RECOMMENDATIONS:**

Therefore, I recommend that the Peer Review Group accept this Corner as monumented, with the references as shown on the enclosed form prepared according to Act 74 of the Public Acts of 1970.

---

Grant J. Ward, R.L.S.  
License No. 22445