

Part  
21143 rd

LIBER 21143 ... 071

**LAND CORNER RECORDATION CERTIFICATE**  
Filing Requirement of Act 74, Mich. P.A. 1970

58664

For corners in

Oakland  
(County)

Located in:

Corner Code #

1. Public Land Survey	T	N	R	7E	L-1
	T		R		
	T		R		
	T		R		
2. Property Controlling in Section	S		T	R	
	S		T	R	
3. Miscellaneous Property in Sec.	S		T	R	
	S		T	R	

LIBER 21143 PAGE 71  
\$9.00 MISC RECORDING  
\$2.00 REMONUMENTATION  
02/28/2000 01:52:10 P.M. RECEIPT# 16297  
PAID RECORDED - OAKLAND COUNTY  
G. WILLIAM CADDELL, CLERK/REGISTER OF DEEDS

Compliance with  
ACT 345, P.A. 1990

APPROVED ON: 7-21-99 JIL  
OAKLAND COUNTY REMONUMENTATION  
PEER GROUP COMMITTEE

Register of Deeds Stamp & File Number

4. Lot No. \_\_\_\_\_, Recorded Plat \_\_\_\_\_  
5. Private Claims \_\_\_\_\_

Grant J. Ward, R.L.S., in a field survey on June 28, 1999 do hereby state that under requirements of P.A. 74, Michigan P.A. of 1970, the corner points mentioned in lines 1 and 2 above were in conformance with regulations and rules therefore as required in the current manual of survey instructions of the United States Department of the Interior, Bureau of Land Management or by a decree of a Court of Law and /or that the corner points mentioned in lines 3, 4 and 5 above were in conformance with the rules of the Michigan Board of Land Surveyors or by a Decree of a Court of Law; established, re-established, monumented, recovered, found as expressed below:

NOTE: Not more than 2 corners, all in the same town and range, may be recorded on this certificate.

	A	B	C	D	E	F	G	H	I	J	K	L	M
1													
2		6		5		4		3		2		1	
3													
4		7		8		9		10		11		12	
5													
6		18		17		16		15		14		13	
7													
8		19		20		21		22		23		24	
9													
10		30		29		28		27		26		25	
11													
12		31		32		33		34		35		36	
13													

A. Description of original monument and accessories and/or subsequent restoration:

L-1 Post, per G.L.O. Notes.

**SURVEY & REMONUMENTATION**

**MAY 24 2000**

**SECTION**

B. Description of corner evidence found and/or method applied in restoring or reestablishing corner:


L-1 North 1/4 Corner of Section 1, T. 2 N., R. 7 E. Found 1/2" Iron Rod.  
Previously Recorded in L. 8644 P. 186 (O) of Oakland County Records.

(n) Indicates the number of references that confirms this corner by dimensional tie.

This corner location of a corner, although not established by an original government survey, is established as the best available evidence of the position of the corner.

C. Description of monument for corner and accessories established to perpetuate locating the position of the corner:

- L-1 Set 5/8" Iron Rod & Remonumentation Cap.
- N 50° E 62.46' Set 60d Nail & Remonumentation Disc in Southeast face of Utility Pole.
- S 50° E 49.52' Set 60d Nail & Remonumentation Disc in Southwest face of Utility Pole.
- S 05° W 59.06' Set 60d Nail & Remonumentation Disc in East face of 36" Maple.
- N 60° W 62.22' Set 60d Nail & Remonumentation Disc in Southwest face of Utility Pole.

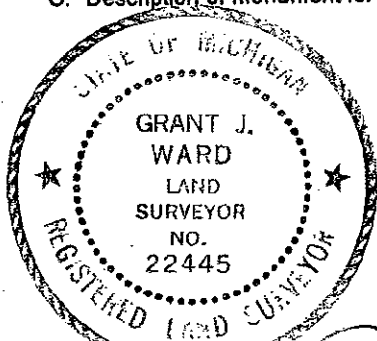

Signed by: [Signature]  
Surveyor's Michigan License No. 22445

Date February 28, 2000