

LIBER 21028 PAGE 603
\$9.00 MISC RECORDING
\$2.00 REMONUMENTATION
01/27/2000 08:21:22 A.M. RECEIPT# 6
PAID RECORDED - OAKLAND COUNTY
G. WILLIAM CADDELL, CLERK/REGISTER OF

Milford
LAND CORNER RECORDATION CERTIFICATE
Filing Requirement of Act 74, Mich. P.A. 1970

For corners in

Oakland _____ Located In: _____ Corner Code # _____
(County)

- 1. Public Land Survey T2N R 7E L-5
T R
T R
T R SURVEY &
REMONUMENTATION
- 2. Property Controlling in Section S T R
S T R
- 3. Miscellaneous Property in Sec. S T R MAR 21 2000
S T R

Compliance with ACT 345, P.A. 1990
APPROVED ON: 7-21-99 JK
OAKLAND COUNTY REMONUMENTATION PEER GROUP COMMITTEE

Register of Deeds Stamp & File Number

4. Lot No. _____, Recorded Plat _____ SECTION _____
5. Private Claims _____

	A	B	C	D	E	F	G	H	I	J	K
1											
2	6		5		4		3		2		
3											
4	7		8		9		10		11		
5											4
6	18		17		16		15		14		1
7											
8	19		20		21		22		23		2
9											
10	30		29		28		27		26		2
11											
12	31		32		33		34		35		3
13											

I, Grant J. Ward, R.L.S., in a field survey on December 9, 1998 do hereby state that under requirements of P.A. 74, Michigan P.A. of 1970, the corner points mentioned in lines 1 and 2 above were in conformance with regulations and rules therefore as required in the current manual of survey instructions of the United States Department of the Interior, Bureau of Land Management or by a decree of a Court of Law and /or that the corner points mentioned in lines 3, 4 and 5 above were in conformance with the rules of the Michigan Board of Land Surveyors or by a Decree of a Court of Law; established, re-established, monumented, recovered, found as expressed below:

NOTE: Not more than 2 corners, all in the same town and range, may be recorded on this certificate.

A. Description of original monument and accessories and/or subsequent restoration:

L-5 Post, per G.L.O. Notes.

B. Description of corner evidence found and/or method applied in restoring or reestablishing corner:

L-5 North 1/4 Corner of Section 13, T. 2 N., R. 7 E. Found State of Michigan Brass Disc in Centerline of Wixom Trail.


Previously Recorded in L. 13392 P. 132 (4) of Oakland County Records.

(n) Indicates the number of references that confirms this corner by dimensional tie.

This corner location is accepted by the contractor and is generally accepted by professional surveyors as the best available evidence of the position of the original corner.

C. Description of monument for corner and accessories established to perpetuate locating the position of the corner:

- L-5 Found State of Michigan Brass Disc, cannot replace.
- N 45° E 45.89' Set 60d Nail & Remonumentation Disc in Northwest face of Utility Pole.
- N 75° E 92.22' Set 60d Nail & Remonumentation Disc in Southeast face of 14" Box Elder.
- S 60° E 87.12' Set 60d Nail & Remonumentation Disc in North face of Twin 12" Locust.
- S 10° W 31.24' Set 60d Nail & Remonumentation Disc in East face of Utility Pole.
- S 10° W 32.94' Found 1/2" Iron Pipe.

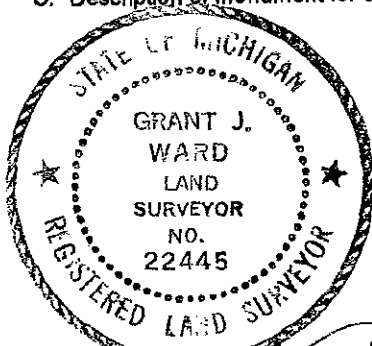

Signed by _____
Surveyor's Michigan License No. 22445

Date July 12, 1999

JULY 3, 1999

Corner Code: L-5

DOSSIER FOR: THE SOUTH 1/4 CORNER OF SECTION 12, MILFORD TOWNSHIP, T 2 N, R 7 E, OAKLAND COUNTY, MICHIGAN. Prepared under contract with the County of Oakland Under Act 345 of the Public Acts of 1990.

HISTORY:

This Corner has been accepted and used since before 1934 as witnessed by the Road Commission for Oakland County at that time. It was recorded under Act 74 of the Public Acts of 1970 in Liber 13392, Page 132, by James J. Scharl, Surveyor in 1993.

COLLATERAL EVIDENCE:

We found a State of Michigan brass cap in an existing monument box. We did not replace it. This Corner lies in the Centerline of Wixom Trail 32.94 feet North of a 1/2" iron pipe. We measured 3.24 feet more and 0.18 feet less than the recorded distances to the Southwest and Southeast Corners of Section 12 respectively. We searched at least 50 feet in each direction for other stakes and found none that might represent the Corner.

SURVEYOR'S RECOMMENDATIONS:

This corner location is accepted by the Contractor and is generally accepted by Professional Surveyors as the best available evidence of the position of the original Corner. Therefore, I recommend that the Peer Review Group accept this Corner as monumented, with the references as shown on the enclosed form prepared according to Act 74 of the Public Acts of 1970.

Grant J. Ward, R.L.S.
License No. 22445

SURVEY &
REMONUMENTATION

MAR 21 2000

SECTION