LIBER 21028 PAGE 619

\$9.00 MISC RECORDING

\$2.00 REMONUMENTATION

LAND CORNER RECORDATION CERTIFICATE

Filing Requirement of Act 74, Mich. P.A. 1970

G. WILLIAM CADDELL, CLERK/REGISTER OF

Oakland	Located In:	Corner Code #
(County)		
1. Public Land Survey	T <u>2N</u> R_ T R_ T R_	
2. Property Controlling in Section	S TR_ S TR_	TO BE WAS TRAITED IN THE STATE OF THE STATE
3. Miscellaneous Property in Sec.	S TR_ S TR	MAR 21 2000
4. Lot No, Record	ed Piat	SECTION


ACT 345, P.A. 1990 8-31-55 54 APPROVED ON: DAKLAND COUNTY REMONUMENTATION PEER GROUP COMMITTEE

Register of Deeds Stamp & File Number

Compliance with

requirements of P.A. 74, Michigan P.A. of 1970, the corner points mentioned in lines 1 and 2 above were in conformance with regulations and rules therefore as required in the current manual of survey instructions of the United States Department of the Interior, Bureau of Land Management or by a decree of a Court of Law and /or that the corner points mentioned in lines 3, 4 and 5 above were in conformance with the rules of the Michigan Board of Land Surveyors or by a Decree of a Court of Law; established, re-established, monumented, recovered, found as expressed below:

NOTE: Not more than 2 corners, all in the same town and range, may be recorded on this certificate.

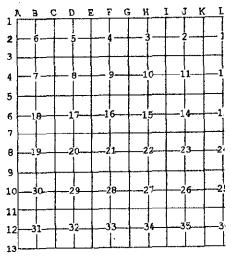

- Description of original monument and accessories and/or subsequent restoration:
 - Post, per G.L.O. Notes. M-7

For corners in


- B: Description of corner evidence found and/or method applied in restoring or reestablishing corner:
 - Southeast Corner of Section 13, T. 2 N., R. 7 E. Found PK Nail. M-7

Previously Recorded in L. 6639 P. 732 (0) of Oakland County Records.

(n) Indicates the number of references that confirms this corner by dimensional tie.

This corner location is accepted by the contractor and is generally accepted by professional surveyors as the best available evidence of the position of the original corner.

C. Description of monument for corner and accessories established to perpetuate locating the position of the corner:

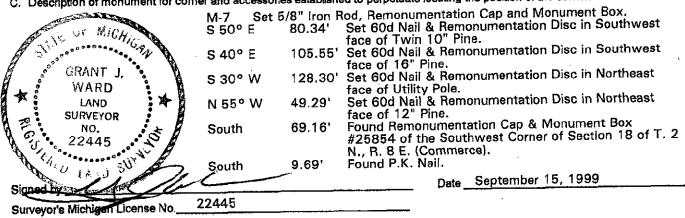

SEPTEMBER 15, 1999

Corner Code: M-7

DOSSIER FOR: THE SOUTHEAST CORNER OF SECTION 13, MILFORD TOWNSHIP, T 2 N, R 7 E, OAKLAND COUNTY, MICHIGAN. Prepared under contract with the County of Oakland Under Act 345 of the Public Acts of 1990.

HISTORY:

This Corner has been witnessed and recorded, however none of the accessories exist at this time.

COLLATERAL EVIDENCE:

The Michigan Department of Natural Resources said that they set the East 1/4 Corner of Section 13 midway and on line with the Southeast and the Northeast Corners of Section 13. Since the Southeast Corner of Section 13 was missing, we set a 5/8" iron rod and remonumentation cap in a new monument box on line with the Northwest Corner of Section 19 of West Bloomfield Township and the East 1/4 Corner of Section 24 of Milford Township the same distance Southerly from the East 1/4 Corner of Section 13 as the Northeast Corner of Section 13 is from the East 1/4 Corner. We found a P.K. Nail in the Centerline of Wixom Road 9.67 feet to the South. We searched at least 50 feet in each direction for other stakes and found none that might represent the Corner.

SURVEYOR'S RECOMMENDATIONS:

This corner location is accepted by the Contractor and is generally accepted by Professional Surveyors as the best available evidence of the position of the original Corner. Therefore, I recommend that the Peer Review Group accept this Corner as monumented, with the references as shown on the enclosed form prepared according to Act 74 of the Public Acts of 1970.

Grant J. Ward, R.L.S. License No. 22445

SURVEY & REMONI IMENTATION

MAR 21 2000

SECTION