

**SURVEY & REMONUMENTATION**

Mar 10 95 040403

LIBER. 15288 PG 489

MAY - 1 1995

**LAND CORNER RECORDATION CERTIFICATE**

Filing Requirement of Act 74, Mich. P.A. 1970

Commerce Twp.

\$ 7.00 MISC RECORDING CHG - IN HOUSE  
 \$ 2.00 REMON CHG - IN HOUSE  
 TO MAR 95 3:58 P.M. RECEIPT# 1778  
 PAID RECORDED - OAKLAND COUNTY  
 LYNN D. ALLEN, CLERK/REGISTER OF DEEDS

**COMMISSION**  
 For corners in Oakland

	(County)	Located In:		Corner Code #
		2N	8E	
1. Public Land Survey		T _____	R _____	A-5
		T _____	R _____	
		T _____	R _____	
		T _____	R _____	
2. Property Controlling in Section		S _____	T _____	R _____
		S _____	T _____	R _____
3. Miscellaneous Property in Sec.		S _____	T _____	R _____
		S _____	T _____	R _____

Compliance with ACT 345, P.A. 1990  
 APPROVED ON: 12-27-94  
 OAKLAND COUNTY REMONUMENTATION PEER GROUP COMMITTEE  
**OK - T. SMITH**  
 Register of Deeds Stamp & File Number

4. Lot No. \_\_\_\_\_, Recorded Plat \_\_\_\_\_  
 5. Private Claims \_\_\_\_\_

	A	B	C	D	E	F	G	H	I	J	K	L	M
2	6		5		4		3		2		1		
3													
4	7		8		9		10		11		12		
5													
6	18		17		16		15		14		13		
7													
8	19		20		21		22		23		24		
9													
10	30		29		28		27		26		25		
11													
12	31		32		33		34		35		36		
13													

I, David Pawlaczyk, in a field survey on December 2, 1994

do hereby certify that under requirements of P.A. 74, Michigan P.A. of 1970, the corner points mentioned in lines 1 and 2 above were in conformance with regulations and rules therefore as required in the current manual of survey instructions of the United States Department of the Interior, Bureau of Land Management or by a decree of a Court of Law and/or that the corner points mentioned in lines 3, 4 and 5 above were in conformance with the rules of the Michigan Board of Land Surveyors or by a Decree of a Court of Law; established, re-established, monumented, re-monumented, recovered, found as expressed below:

**NOTE: Not more than 4 corners, all in the same town and range, may be recorded on this certificate.**

**A. Description of original monument and accessories and/or subsequent restoration:**

1981 1/2" iron rod in mon. box L.C.R.C. H. Kennedy #17623 L8096 P222

**B. Description of corner evidence found and/or method applied in restoring or reestablishing corner:**

A 1/2" iron rod in asphalt pavement currently occupies this corner. A 1/2" iron rod in an existing monument box lies southwesterly 7.00' from the 1/2" iron rod. No accessories exist from L.C.R.C. L8096 P222.


Field measurements were made between the following corners:

A-5 to A-4	2622.05	meas.		
	2622.12	rec.	Property desc.	Oakland County Planning
A-5 to B-5	2907.42	meas.		
	2907.15	rec.	Property desc.	Oakland County Planning Plats L91-26
A-5 to A-6	2512.58	meas.		
A-5 to M-5	125.93	meas.		
	130.02	rec.	G.L.O.	Notes

**C. Description of monument for corner and accessories established to perpetuate locating the position of the corner:**

I placed a 5/8" x 24" iron rod with a 2" diameter brass cap stamped "Oakland County Remonumentation PS 17632" with a new monument box over the existing 1/2" iron rod in asphalt pavement.

Due North	125.93'	1/2" iron rod in mon. box (E. 1/4 corner T-2-N., R-7-E.)
S.46° W.	7.00'	1/2" iron rod in mon. box
N.31° W.	150.43'	P.K. nail and O.C.R. tag wood post
S.26° E.	73.46'	P.K. nail and O.C.R. tag sign post
N.41° E.	58.88'	P.K. nail and O.C.R. tag street light

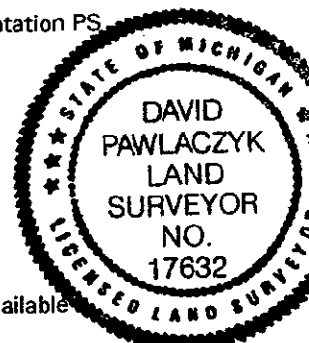

The selected location is accepted by me and generally accepted by Professional Surveyors as the best available evidence of the position of the original corner.

Signed by [Signature] Date 2-16-95

Surveyor's Michigan License No. 17632