

MAR 11 1999

LAND CORNER RECORDATION CERTIFICATE
Filing Requirement of Act 74, Mich. P.A. 1970


For corners in SECTION

Table with columns: Oakland (County), Located In: Commerce Township, Corner Code #. Rows include Public Land Survey, Property Controlling in Section, Miscellaneous Property in Sec.

\$ 7.00 MISCELLANEOUS RECORDING
\$ 2.00 REMONUMENTATION
6 NOV 98 9:58 A.M. RECEIPT# 28A
PAID G. WILLIAM CADELL
OAKLAND COUNTY REMONUMENTATION PEER GROUP COMMITTEE
Register of Deeds Stamp & File Number

4. Lot No. , Recorded Plat
5. Private Claims

I, Randy Kolehouse, in a field survey on August 13 19 97, do hereby certify that under requirements of P.A. 74 Michigan P.A. of 1970, the corner points mentioned in lines 1 and 2 above were in conformance with regulations and rules therefore as required in the current manual of survey instructions of the United States Department of the interior, Bureau of Land Management or by a decree of a Court of Law and/or that the corner points mentioned in lines 3, 4 and 5 above were in conformance with the rules of the Michigan Board of Land Surveyors or by a Decree of a Court of Law; established, re-established, monumented, re-monumented, recovered, found as expressed below:

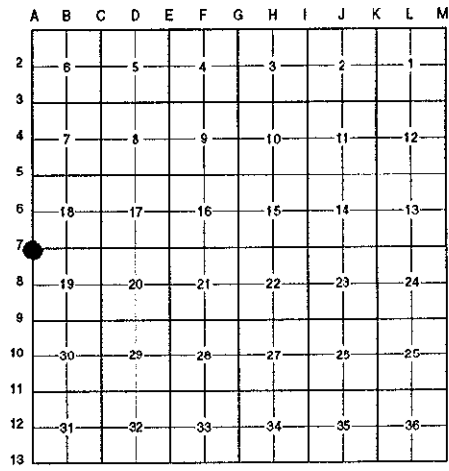

NOTE: Not more than 4 corners, all in the same town and range, may be recorded on this certificate.

A. Description of original monument and accessories and/or subsequent restoration:

Table with 4 columns: Description, G.L.O. Notes, and Set Post. Rows include Wampler, Wizynajty, Bonno, and N/A.

Records indicate this corner is not common with M-7, T2N, R7E.

B. Description of corner evidence found and/or method applied in restoring or reestablishing corner:

A-7 Found a monument box on the C/L of Wixom Road (bit.) running North and South 0.4' below grade. Could not remove cover. Held C/L of monument box for corner. Checks two remaining witnesses from L.C.R.C. L. 10563 p. 317. Also checks irons set in Cert. Survey L. 10526 p. 845 and 846

L.C.R.C. L. 10563 P. 317
S 45° W Util. Pole 69.0' (m. 70.15')
N 45° E Scotch Pine 66.76' (m. 66.82')

Measure North 2615.14' to A-6 (G.L.O. = 2640.00')
Measure South 2679.51' to A-8 (G.L.O. = 2640.00') Cert. Survey L. 10526 P. 845 = 2679.49
Measure East 5547.3' to C-7 (G.L.O. = 5556.5')

C. Description of monument for corner and accessories established to perpetuate locating the position of the corner:

A-7 Removed monument box. Replaced with a 5/8" x 24" rebar with brass cap stamped "Oakland County Remonumentation P.S. #25854." Also set a new monument box.

- PK Nail & Tag Stamped "Oakland Co. Remonumentation P.S. #25854" in N Face Twin 8" Pine S 65E 62.61'
PK Nail & Tag Stamped "Oakland Co. Remonumentation P.S. #25854" in N Face Triple 8" Pine N 85° E 66.82'
PK Nail & Tag Stamped "Oakland Co. Remonumentation P.S. #25854" in Util. Pole S 45° W 70.15'
PK Nail & Tag Stamped "Oakland Co. Remonumentation P.S. #25854" in Pine N 45° E 102.25'

The selected location is accepted by the Contractor and is generally accepted by professional surveyors as the best available evidence of the position of the original corner.

Signed by Randy J. Kolehouse Date Aug 3, 1998
EARTH TECH
Surveyor's Michigan License No. 25854

