

**COPY**  
REMONUMENTATION

LIBER 16860PG 085

Dec 26 96 309614

MAY 22 1997

**LAND CORNER RECORDATION CERTIFICATE**

Filing Requirement of Act 74, Mich. P.A. 1970 \$ 7.00 MISCELLANEOUS RECORDING

For corner in **COMMISSION**

\_\_\_\_\_ Oakland \_\_\_\_\_ Located In: \_\_\_\_\_ Corner Code # \_\_\_\_\_  
 (county)

1. Public Land Survey T 2N R 8E A-10  
 T \_\_\_\_\_ R \_\_\_\_\_  
 T \_\_\_\_\_ R \_\_\_\_\_  
 T \_\_\_\_\_ R \_\_\_\_\_

2. Property Controlling S \_\_\_\_\_ T \_\_\_\_\_ R \_\_\_\_\_  
 in Section S \_\_\_\_\_ T \_\_\_\_\_ R \_\_\_\_\_

3. Miscellaneous S \_\_\_\_\_ T \_\_\_\_\_ R \_\_\_\_\_  
 Property in Sec. S \_\_\_\_\_ T \_\_\_\_\_ R \_\_\_\_\_

\$ 2.00 REMONUMENTATION  
 26 DEC 96 9:23 A.M. RECEIPT# 7B  
 PAID RECORDED - OAKLAND COUNTY  
 LYNN D. ALLEN, CLERK/REGISTER OF DEEDS

Compliance with  
 ACT 345, P.A. 1990

APPROVED ON: 11-25-96 TS  
 OAKLAND COUNTY REMONUMENTATION  
 PEER GROUP COMMITTEE

Register of Deeds Stamp & File Number

4. Lot No. \_\_\_\_\_, Recorded Plat \_\_\_\_\_

5. Private Claims \_\_\_\_\_

I, James E. Kovas, in a field survey on November 19, 1996, do hereby certify that under requirements of P.A. 74, Michigan P.A. of 1970, the corner points mentioned in lines 1 and 2 above were in conformance with regulations and rules therefore as required in the current manual of survey instructions of the United States Department of the Interior, Bureau of Land Management or by a decree of a Court of Law and/or that the corner points mentioned in lines 3, 4 and 5 above were in conformance with the rules of the Michigan Board of Land Surveyors or by a Decree of a Court of Law; established, re-established, monumented, re-monumented, recovered, found as expressed below:

	A	B	C	D	E	F	G	H	I	J	K	L	M
2	6		5		4		3		2				
3													
4	7		8		9		10		11		12		
5													
6	16		17		18		15		14		13		
7													
8	19		20		21		22		23		24		
9													
10	30		29		28		27		26		25		
11													
12	31		32		33		34		35		36		
13													

**NOTE: Not more than 4 corners, all in the same town and range, may be recorded on this certificate.**

**A. Description of original monument and accessories and/or subsequent restoration:**

A-10  
 1816 - G.L.O. Set 1/4 Post  
 1973 - Hubbell, Roth & Clark, LCRC (Liber 6253, Page 752) 1/2" Square Steel Rod WIT: West, 18.82', 16d Nail S.Face 6" Basswood; S45°E, 11.61', 16d Nail SW Face 14" Maple; S20°W, 26.38', 16d Nail E.Face 10" Wild Cherry.  
 1994 - T. Wozniak, PS#15066, LCRC (Liber 14709, Page 322) Square Iron WIT: N65°W, 19.51', Pk Nail N.Face Tree; S25°W, 17.28', Pk Nail W.Face 6" Tree; S65°E, 11.46', Pk Nail N.Face 11" Tree; N10°W 15.62', Pk Nail W.Face 6" Tree.

Distances: A-10 to A-9 = 2657.29' (Wade-Trim)  
 A-10 to A-11 = 2625.47' (Wade-Trim)

**B. Description of corner evidence found and/or method applied in restoring or reestablishing corner:**


A-10  
 Found Square Steel Rod in Swamp  
 WIT: N65°W 19.50' Fnd Pk Nail N.Face 7" Tree  
 S25°W 17.20' Fnd Pk Nail W.Face 6" Tree  
 S65°E 11.48' Fnd Pk Nail N.Face 11" Tree  
 N10°W 15.62' Fnd Pk Nail W.Face 6" Tree

The Square Steel Rod found was ratified by the Peer Review Committee on November 25, 1996, as the accepted corner.

**C. Description of monument for corner and accessories established to perpetuate locating the position of the corner:**

A-10 Set Concrete Monument with Brass Oakland Co. Remonumentation Cap# 33138, in swamp, at location of Square Steel Rod.  
 (Square Steel Rod re-set to North of concrete monument)

WIT: N65°W 19.57' Set 60d Nail/ Oakland Remon Brass Tag#33138 N.Face 8" Elm  
 S70°W 76.14' Set 60d Nail/ Oakland Remon Brass Tag#33138 N.Face 18" Maple  
 S55°E 15.59' Set 60d Nail/ Oakland Remon Brass Tag#33138 N.Face 12" Elm  
 N40°E 35.54' Set 60d Nail/ Oakland Remon Brass Tag#33138 W.Face 5" Elm

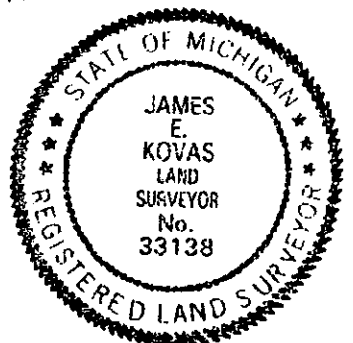

Signed by James E. Kovas Date December 20, 1996

Surveyor's Michigan License No. 33138

*702 file  
202*