

MAY 16 1996

COMMISSION LAND CORNER RECORDATION CERTIFICATE
Filing Requirement of Act 74, Mich. P.A. 1970

For corners in


_____ (County) _____	Located In: _____	Corner Code # _____
_____ (Township) _____	Commerce Twp.	

1. Public Land Survey	T <u>2N</u> R <u>8E</u>	<u>C-2</u>
	T _____ R _____	_____
	T _____ R _____	_____
	T _____ R _____	_____
2. Property Controlling in Section	S _____ T _____ R _____	_____
	S _____ T _____ R _____	_____
3. Miscellaneous Property in Section	S _____ T _____ R _____	_____
	S _____ T _____ R _____	_____

Compliance with ACT 345, P.A. 1990
 APPROVED ON: 12-07-95 T.S.
 OAKLAND COUNTY REMONUMENTATION
 PEER GROUP COMMITTEE

Register of Deeds Stamp & File Number

4. Lot No. _____, Recorded Plat _____
 5. Private Claims _____

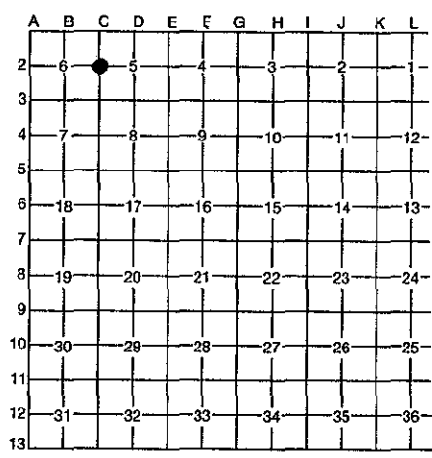

I, David Pawlaczyk, in a field survey on October 17, 1995, do hereby certify that under requirements of P.A. 74, Michigan P.A. of 1970, the corner points mentioned in lines 1 and 2 above were in conformance with regulations and rules therefore as required in the current manual of survey instructions of the United States Department of the Interior, Bureau of Land Management or by a decree of a Court of Law and/or that the corner points mentioned in lines 3, 4 and 5 above were in conformance with the rules of the Michigan Board of Professional Surveyors or by a Decree of a Court of Law; established, re-established, monumented, re-monumented, recovered, found as expressed below:

NOTE: Not more than 4 corners, all in the same town and range, may be recorded on this certificate.

A. Description of original monument and accessories and/or subsequent restoration:

1823 Post	G.L.O. A. Holmes	N/A	Notes
1980 Set 1/2" iron	Survey D. Finney	#15536	L7854 P688
1980 N/A	Survey D. Finney	#15536	L8090 P615

\$ 7.00 MISCELLANEOUS RECORDING
 \$ 2.00 REMONUMENTATION
 27 DEC 95 9:59 A.M. RECEIPT# 54B
 PAID RECORDED - OAKLAND COUNTY
 LYNN D. ALLEN, CLERK/REGISTER OF DEEDS

B. Description of corner evidence found and/or method applied in restoring or reestablishing corner:

A found 1/2" iron rod in old remains of wood and wire fence currently occupies this corner. No witness ties were available for this corner.

Field measurements were made between the following corners:

C-1 to C-2	2910.26 meas.
	2907.96 Rec. G.L.O.
	2910.14 Rec. Survey L8090 P615
C-2 to C-3	2641.73 Meas.
	2640.00 Rec. G.L.O.
	2643.32 Rec. survey L7854 P688

C. Description of monument for corner and accessories established to perpetuate locating the position of the corner:

I replaced the 1/2" iron rod with a 4" x 36" concrete monument with a 2" diameter brass cap stamped "Oakland County Remonumentation PS 17632"

N. 35° E. 9.33'	P.K. Nail & O.C.R. tag S.E. face 18" Maple
S. 50° E. 14.65'	P.K. Nail & O.C.R. tag N.E. face 18" Elm
S. 32° W. 12.80'	P.K. Nail & O.C.R. tag E. face 40" Oak
N. 68° N. 19.35'	P.K. Nail & O.C.R. tag N.E. face 16" Maple
N. 30' W. 16.11'	P.K. Nail & O.C.R. tag E. face 20" Maple



The selected location is accepted by me and generally accepted by Professional Surveyors as the best available evidence of the position of the original corner.

Signed by [Signature]
 Surveyor's Michigan License No. 17632

Date 12-20-95