

MAY 16 1996

LIBER 15397 PAGE 587

MAY 11 1950 84078

COMMISSION LAND CORNER RECORDATION CERTIFICATE

For corners in Oakland Commerce Twp.

Table with columns: (County), Located In, Corner Code ##. Rows include Public Land Survey, Property Controlling in Section, Miscellaneous Property in Sec.

7.00 MISCELLANEOUS RECORDING \$ 2.00 REMONUMENTATION 11 MAY 95 9:04 A.M. RECEIPT# 12B PAID RECORDED - OAKLAND COUNTY LYNN D. ALLEN, CLERK/REGISTER OF DEEDS


Compliance with ACT 345, P.A. 1990

APPROVED ON: 1-23-95 OAKLAND COUNTY REMONUMENTATION PEER GROUP COMMITTEE Register of Deeds Stamp & File Number

4. Lot No. Recorded Plat 5. Private Claims

I, David Pawlaczyk, in a field survey on January 11, 1995, do hereby certify that under requirements of P.A. 74, Michigan P.A. of 1970, the corner points mentioned in lines 1 and 2 above were in conformance with regulations and rules therefore as required in the current manual of survey instructions of the United States Department of the Interior, Bureau of Land Management or by a decree of a Court of Law and/or that the corner points mentioned in lines 3, 4 and 5 above were in conformance with the rules of the Michigan Board of Land Surveyors or by a Decree of a Court of Law, established, re-established, monumented, re-monumented, recovered, found as expressed below:

NOTE: Not more than 4 corners, all in the same town and range, may be recorded on this certificate.

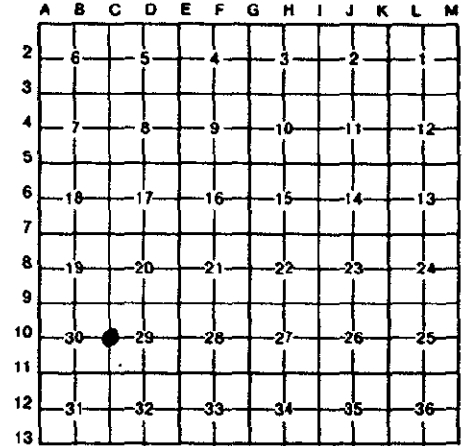

A. Description of original monument and accessories and/or subsequent restoration:

Table with columns: Date, Description, Surveyor, Monument Number, Notes. Includes entries for 1816 Post, 1989 P.K. Nail with RJD tag, 1991 Found nail.

Handwritten initials and date: 1-23-95

B. Description of corner evidence found and/or method applied in restoring or reestablishing corner:

A P.K. nail with an RJD washer currently marks this corner. A P.K. nail was also found 0.3' N. and 2.5' E. of aforementioned nail and washer. The following ties were used to recover and verify its position: 2 ties from Unrecorded Survey by P.S. 12584 2 ties from L.C.R.C. L11231 P782

Field measurements were observed between the nail with RJD washer and the following corners:

Table with columns: Corner Pair, Distance, Measurement Type, Surveyor, Notes. Includes entries for C-10 to C-9 and C-10 to C-11.

C. Description of monument for corner and accessories established to perpetuate locating the position of the corner:

I replaced the P.K. nail w/RJD washer with a 5/8" x 24" iron rod and a 2" brass cap stamped "Oakland County Remonumentation P.S. #17632" with a new monument box in asphalt pavement.

Table with columns: Angle, Distance, Description. Includes entries for N.35° E. 82.48', S.71° E. 83.12', S.42° W. 60.50', N.48° W. 67.02'.

The selected location is accepted by me and generally accepted by Professional Surveyors as the best available evidence of the position of the original corner.



Signed by [Signature] Date 2-16-95

Surveyor's Michigan License No. 17632