

MAY 16 1996

LIBER 15397 PAGE 588

COMMISSION LAND CORNER RECORDATION CERTIFICATE

Filing Requirement of Act 74, Mich. P.A. 1970

For corners in Oakland

Commerce Twp.

\$ 7.00 MISCELLANEOUS RECORDING


\$ 2.00 REMONUMENTATION

11 MAY 95 9:04 A.M. RECEIPT# 12B PAID RECORDED - OAKLAND COUNTY LYNN D. ALLEN, CLERK/REGISTER OF DEEDS

Compliance with ACT 345, P.A. 1990

APPROVED ON: 1-23-95 OAKLAND COUNTY REMONUMENTATION PEER GROUP COMMITTEE Register of Deeds Stamp & File Number

Table with columns: (County), Located In: (Township), Corner Code #. Rows include Public Land Survey, Property Controlling in Section, Miscellaneous Property in Sec., Lot No., and Private Claims.

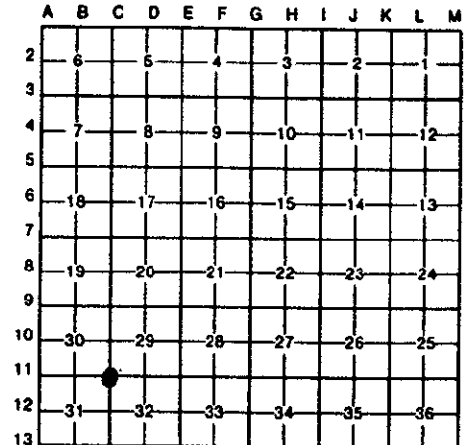

I, David Pawlaczyk, in a field survey on January 3, 1995, do hereby certify that under requirements of P.A. 74, Michigan P.A. of 1970, the corner points mentioned in lines 1 and 2 above were in conformance with regulations and rules therefore as required in the current manual of survey instructions of the United States Department of the Interior, Bureau of Land Management or by a decree of a Court of Law and/or that the corner points mentioned in lines 3, 4 and 5 above were in conformance with the rules of the Michigan Board of Land Surveyors or by a Decree of a Court of Law; established, re-established, monumented, re-monumented, recovered, found as expressed below:

NOTE: Not more than 4 corners, all in the same town and range, may be recorded on this certificate.

A. Description of original monument and accessories and/or subsequent restoration:

Table with columns: Date, Description, G.L.O., Surveyor Name, Monument #, Notes. Includes entries for 1816 Post, 1978 N/A, 1987 P.K. Nail, 1987 Monument box, 1991 Found Iron, and 1992 1/2" Iron in mon. box.

Handwritten signature/initials.

B. Description of corner evidence found and/or method applied in restoring or reestablishing corner:

A 1/2" iron rod in a monument box in asphalt pavement currently occupies this corner.

Field measurements were made between the following corners:

Table with columns: Corner Pair, Distance, Measurement Type, G.L.O., Surveyor Name, Notes. Includes measurements between C-11 to C-10, C-11 to D-11, and C-11 to C-12.

C. Description of monument for corner and accessories established to perpetuate locating the position of the corner:

I placed a 2" diameter brass cap stamped "Oakland County Remonumentation P.S. #17632" on the existing 1/2" iron rod in a monument box in asphalt pavement.

Table with columns: Angle, Distance, Description. Includes bearings like N.37° W. and distances like 78.19'.

The selected location is accepted by me and generally accepted by Professional Surveyors as the best available evidence of the position of the original corner.



Signed by [Signature]

Date 2-16-95

Surveyor's Michigan License No. 17632