

MAY 16 1996

LISER 15907pc745

DEC 27 1995 257035

**COMMISSION LAND CORNER RECORDATION CERTIFICATE**  
**Filing Requirement of Act 74, Mich. P.A. 1970**


For corners in Oakland (County) Located In: Commerce Twp Corner Code # \_\_\_\_\_

	2N	8E	E-2
1. Public Land Survey	T _____	R _____	_____
	T _____	R _____	_____
	T _____	R _____	_____
	T _____	R _____	_____
2. Property Controlling in Section	S _____	T _____	R _____
	S _____	T _____	R _____
3. Miscellaneous Property in Section	S _____	T _____	R _____
	S _____	T _____	R _____

Compliance with ACT 345, P.A. 1990  
 APPROVED ON: 12-07-95 T.S.  
 OAKLAND COUNTY REMONUMENTATION PEER GROUP COMMITTEE

Register of Deeds Stamp & File Number

4. Lot No. \_\_\_\_\_, Recorded Plat \_\_\_\_\_  
 5. Private Claims \_\_\_\_\_

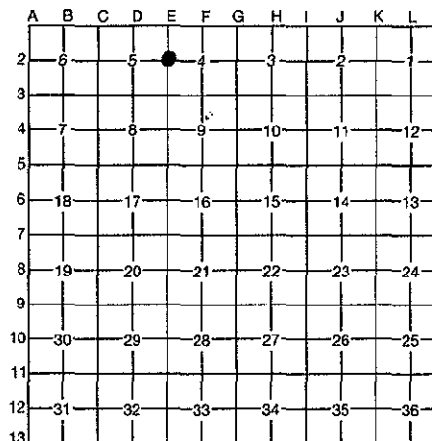

I, David Pawlaczyk, in a field survey on December 15, 1994, do hereby certify that under requirements of P.A. 74, Michigan P.A. of 1970, the corner points mentioned in lines 1 and 2 above were in conformance with regulations and rules therefore as required in the current manual of survey instructions of the United States Department of the Interior, Bureau of Land Management or by a decree of a Court of Law and/or that the corner points mentioned in lines 3, 4 and 5 above were in conformance with the rules of the Michigan Board of Professional Surveyors or by a Decree of a Court of Law; established, re-established, monumented, re-monumented, recovered, found as expressed below:

**NOTE: Not more than 4 corners, all in the same town and range, may be recorded on this certificate.**

**A. Description of original monument and accessories and/or subsequent restoration:**

Date	Description	Survey	Surveyor	Accessories	Notes
1823	Post	G.L.O.	A. Holmes	N/A	
1931	Iron pipe	Survey	M. Baldwin	N/A	BK17A P18
1936	N/A	Survey	M. Baldwin	N/A	BK17A P26
1972	1/2" iron rod	Survey	J. Albright	#10057	L6002 P504-507
1973	1/2" iron rod	L.C.R.C.	J. Albright	#10057	L6214 P191
1973	3/4" iron pipe	Survey	G. Kattouah	#14095	L6162 P286
1975	3/8" iron found	L.C.R.C.	J. Scharl	#19843	L7177 P592
1980	Found nail	Survey	D. Williams	#25880	L8112 P39

**B. Description of corner evidence found and/or method applied in restoring or reestablishing corner:**

A P.K. nail and a 3/8" iron rod in asphalt pavement currently occupies this corner. The following witness ties were used to best verify the P.K. nail's position:

2 ties very nearly match M. Baldwin ties		
3 ties match	Survey	Witnesses
	L.C.R.C.	
3 ties match	L.C.R.C.	
3 ties match	Survey	Witnesses

L6002 P504  
 L6214 P191 7.00 MISCELLANEOUS RECORDING  
 L7177 P592 2.00 REMONUMENTATION  
 L8112 P39 27 DEC 95 9:59 A.M. RECEIPT# 54B  
 PAID RECORDED - OAKLAND COUNTY  
 LYNN D. ALLEN, CLERK/REGISTER OF DEEDS

Field measurements were made between the following corners:

E-1 to E-2	E-2 to E-3
2896.02 meas.	2644.25 meas.
2907.96 G.L.O.	2640.00 rec. G.L.O.
2921.54 rec. M. Baldwin	2650.69 rec. M. Baldwin
2897.27 rec. L6162 P286	2646.24 rec. L6002 P504
2896.77 rec. L8112 P39	

**C. Description of monument for corner and accessories established to perpetuate locating the position of the corner:**

I replaced the found P.K. nail in asphalt pavement with a 3/4" x 24" iron with a 2" diameter brass cap stamped "Oakland County Remonumentation PS #17632" in a new monument box.

N 50° W. 29.19'	P.K. nail & O.C.R. Tag	S.W. Face	36" Maple
Due West 33.14'	Found 1/2" iron		
S 25° W. 46.75'	P.K. nail & O.C.R. Tag	N. face	15" Oak
S 20° W. 50.05'	P.K. nail & O.C.R. Tag	S.E. face	26" Oak
S 20° W. 2.19'	Found 1/2" iron in asphalt pavement		

The selected location is accepted by me and generally accepted by Professional Surveyors as the best available evidence of the position of the original corner.



Signed by [Signature]  
 Surveyor's Michigan License No. 17632

Date 12-20-95