

**SURVEY & REMONUMENTATION**

MAY - 1 1995

LIBER 15288 PG 528

MAR 10 95 04 04 42

**COMMISSION**

**LAND CORNER RECORDATION CERTIFICATE**

Filing Requirement of Act 74, Mich. P.A. 1970

\$ 7.00 MISC RECORDING CHG - IN HOUSE  
 \$ 2.00 REMON CHG - IN HOUSE  
 10 MAR 95 4:04 P.M. RECEIPT# 1778  
 PAID RECORDED - OAKLAND COUNTY  
 LYNN D. ALLEN, CLERK/REGISTER OF DEEDS

For corners in Oakland  
 (County)

Located in: Commerce Twp. Corner Code #

	2N	8E	E-3
1. Public Land Survey	T _____	R _____	_____
	T _____	R _____	_____
	T _____	R _____	_____
	T _____	R _____	_____
2. Property Controlling in Section	S _____	T _____	R _____
	S _____	T _____	R _____
3. Miscellaneous Property in Sec.	S _____	T _____	R _____
	S _____	T _____	R _____


Compliance with ACT 345, P.A. 1990  
 APPROVED ON: 12-13-94  
 OAKLAND COUNTY REMONUMENTATION PEER GROUP COMMITTEE  
**OK - T. SMITH**  
 Register of Deeds Stamp & File Number

4. Lot No. \_\_\_\_\_, Recorded Plat \_\_\_\_\_  
 5. Private Claims \_\_\_\_\_

David Pawlaczyk December 1 94

I, \_\_\_\_\_, in a field survey on \_\_\_\_\_, 19 \_\_\_\_\_, do hereby certify that under requirements of P.A. 74, Michigan P.A. of 1970, the corner points mentioned in lines 1 and 2 above were in conformance with regulations and rules therefore as required in the current manual of survey instructions of the United States Department of the Interior, Bureau of Land Management or by a decree of a Court of Law and/or that the corner points mentioned in lines 3, 4 and 5 above were in conformance with the rules of the Michigan Board of Land Surveyors or by a Decree of a Court of Law; established, re-established, monumented, re-monumented, recovered, found as expressed below:

**NOTE: Not more than 4 corners, all in the same town and range, may be recorded on this certificate.**

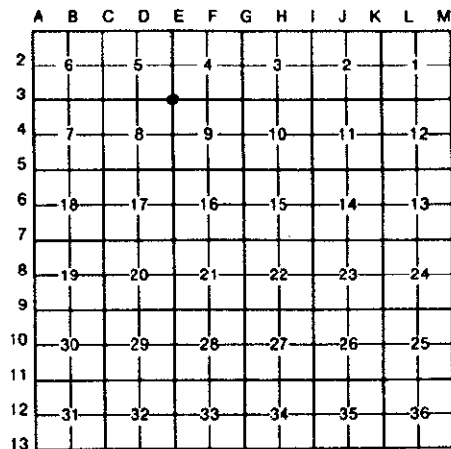

**A. Description of original monument and accessories and/or subsequent restoration:**

	1815 Post	G.L.O. Survey	A. Holmes J. Albright	N/A #10057	Notes
	1972 1/2" Re-rod	L.C.R.C.	J. Albright	#10057	L6002 P504
	1973 1/2" Re-rod			#10057	L6214 P191

**B. Description of corner evidence found and/or method applied in restoring or reestablishing corner:**

A 1/2" iron rod in an existing monument box in asphalt pavement currently occupies this corner. No accessories from L.C.R.C. L6214 P191 currently exist.

The following measurements were made between these corners:

Line	Measurement	Method	Notes
E-3 to F-3	2666.46	meas.	
	2660.13	rec.	G.L.O.
E-3 to D-3	2666.01	meas.	
	2644.95	rec.	G.L.O.

**C. Description of monument for corner and accessories established to perpetuate locating the position of the corner:**

I placed a 2" diameter brass cap on an existing 1/2" iron rod in an existing monument box in asphalt pavement stamped "Oakland County Remonumentation PS #17632".

- N.15° W. 132.95' P.K. nail and O.C.R. tag in N.E. face 12" Pine
- N.77° W. 93.73' P.K. nail and O.C.R. tag in S. face 10" Ash
- S.30° W. 92.06' P.K. nail and O.C.R. tag in E. face 6" Tree
- S.40° E. 92.08' P.K. nail and centerline road sign

The selected location is accepted by me and generally accepted by Professional Surveyors as the best available evidence of the position of the original corner.

Signed by [Signature]

Date 2-16-95

Surveyor's Michigan License No. 17632

