

**SURVEY & REMONUMENTATION**

LIBER **15288** PG **529**

MAR 10 95 040443

MAY - 1 1995

**LAND CORNER RECORDATION CERTIFICATE**

\$ 7.00 MISC RECORDING CHG - IN HOUSE  
 \$ 2.00 REMON CHG - IN HOUSE  
 MAR 95 4:05 P.M. RECEIPT# 1778  
 PAID RECORDED - OAKLAND COUNTY  
 LYNN D. ALLEN, CLERK/REGISTER OF DEEDS

For corners in **COMMISSION**  
 Oakland

Filing Requirement of Act 74, Mich. P.A. 1970  
 Commerce Twp.

(County)	Located In:	Corner Code #
	2N 8E	E-6
1. Public Land Survey	T _____ R _____	_____
	T _____ R _____	_____
	T _____ R _____	_____
	T _____ R _____	_____
2. Property Controlling in Section	S _____ T _____ R _____	_____
	S _____ T _____ R _____	_____
3. Miscellaneous Property in Sec.	S _____ T _____ R _____	_____
	S _____ T _____ R _____	_____


**OK - T. SMITH**  
 Compliance with ACT 345, P.A. 1990  
 APPROVED ON: 12-13-94  
 OAKLAND COUNTY REMONUMENTATION PEER GROUP COMMITTEE

Register of Deeds Stamp & File Number

4. Lot No. \_\_\_\_\_, Recorded Plat \_\_\_\_\_  
 5. Private Claims \_\_\_\_\_

David Pawlaczyk December 2 94

I, \_\_\_\_\_, in a field survey on \_\_\_\_\_, 19\_\_\_\_\_, do hereby certify that under requirements of P.A. 74, Michigan P.A. of 1970, the corner points mentioned in lines 1 and 2 above were in conformance with regulations and rules therefore as required in the current manual of survey instructions of the United States Department of the Interior, Bureau of Land Management or by a decree of a Court of Law and/or that the corner points mentioned in lines 3, 4 and 5 above were in conformance with the rules of the Michigan Board of Land Surveyors or by a Decree of a Court of Law; established, re-established, monumented, re-monumented, recovered, found as expressed below:

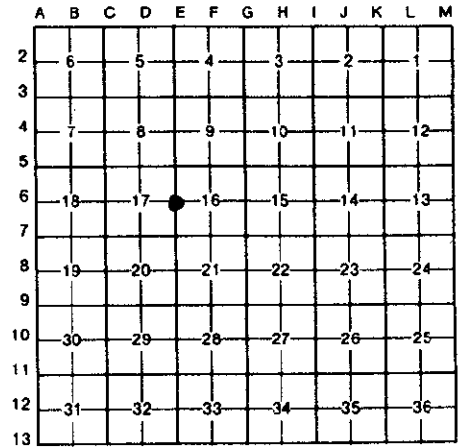

**NOTE: Not more than 4 corners, all in the same town and range, may be recorded on this certificate.**

**A. Description of original monument and accessories and/or subsequent restoration:**

Date	Description	Surveyor	Accessories	Notes
1815	Post	G.L.O.	A. Holmes	N/A
1973	Iron rod	Survey	C. Naber	#17630
1983	1/2" Iron rod	Survey	B. Thompson	#23828
1988	1/2" Re-rod	L.C.R.C.	D. Finney	#15536

**B. Description of corner evidence found and/or method applied in restoring or reestablishing corner:**

A 1/2" iron rod in a gravel road 0.5' below surface currently occupies this corner. The following witness ties were used to recover and verify its current position:

- 3 ties match survey witness L6199 P36
- 3 ties match survey witness L8495 P451
- 2 ties match L.C.R.C. L10848 P873

Field measurements were made between the following corners:

From Corner	Distance	Method	Surveyor	Notes
E-6 to E-5	2665.38	meas.		
	2640.00	rec.	G.L.O.	

**C. Description of monument for corner and accessories established to perpetuate locating the position of the corner:**

I placed a 2" diameter brass cap stamped "Oakland County Remonumentation PS #17632" on the existing 1/2" iron in the gravel road.

N.82° W.	33.03'	P.K. nail and O.C.R. tag in N. face 38" Oak
N.60° E.	48.92'	P.K. nail and O.C.R. tag in N.W. face Twin 12" Oak
S.74° E.	80.73'	P.K. nail and O.C.R. tag in N. face Twin 36" Oak
S.37° W.	35.92'	P.K. nail and O.C.R. tag in N.W. face 24" Oak

The selected location is accepted by me and generally accepted by Professional Surveyors as the best available evidence of the position of the original corner.

Signed by: [Signature] 17632

Date 2-16-95

Surveyor's Michigan License No. \_\_\_\_\_

