

MAY 16 1996


COMMISSION LAND CORNER RECORDATION CERTIFICATE
Filing Requirement of Act 74, Mich. P.A. 1970

For corners in Oakland Located In: Commerce Twp. Corner Code #
 (County)

1. Public Land Survey T 2N R 8E E 9
 T _____ R _____
 T _____ R _____
 T _____ R _____
2. Property Controlling S _____ T _____ R _____
 in Section S _____ T _____ R _____
3. Miscellaneous S _____ T _____ R _____
 Property in Section S _____ T _____ R _____
4. Lot No. _____, Recorded Plat _____
5. Private Claims _____

Compliance with
 ACT 345, P.A. 1990
 APPROVED ON: 12-07-95 T.S.
**OAKLAND COUNTY REMONUMENTATION
 PEER GROUP COMMITTEE**

Register of Deeds Stamp & File Number

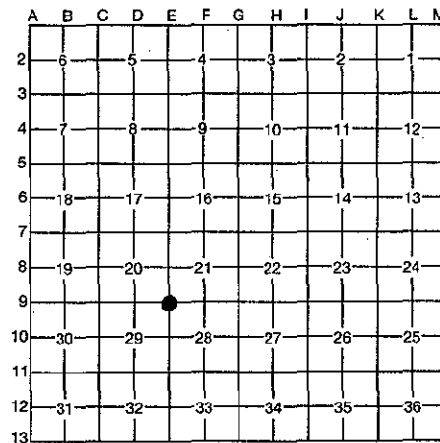

I, David Pawlaczyk, in a field survey on October 4, 1995, do hereby certify that under requirements of P.A. 74, Michigan P.A. of 1970, the corner points mentioned in lines 1 and 2 above were in conformance with regulations and rules therefore as required in the current manual of survey instructions of the United States Department of the Interior, Bureau of Land Management or by a decree of a Court of Law and/or that the corner points mentioned in lines 3, 4 and 5 above were in conformance with the rules of the Michigan Board of Professional Surveyors or by a Decree of a Court of Law; established, re-established, monumented, re-monumented, recovered, found as expressed below:

NOTE: Not more than 4 corners, all in the same town and range, may be recorded on this certificate.

A. Description of original monument and accessories and/or subsequent restoration:

Date	Description	G.L.O.	Surveyor	Accessories	Notes
1823	Post	G.L.O.	A. Holmes	N/A	Unrecorded
1989	N/A	Survey	D. Smith	#33140	
1992	Found 1/2" Pipe 6' North of fence & 15' West of wire fence	L.C.R.C.	D. Smith	#33140	L13174 P139

\$ 7.00 MISCELLANEOUS RECORDING
 27 DEC 95 9:55 A.M. RECEIPT# 54B
 PAID RECORDED - OAKLAND COUNTY
 LYNN D. ALLEN, CLERK/REGISTER OF DEEDS
 \$ 2.00 REMONUMENTATION

B. Description of corner evidence found and/or method applied in restoring or reestablishing corner:

A 1/2" iron pipe in a field currently occupies this corner. The following witness ties were used to recover and verify its position:
 3 ties match L.C.R.C. L13174 P139

Field measurements were made between the following corners:

E-9 to F-9	2641.92	meas.
	2642.64	G.L.O.
	2644.76	Rec. O.C. Tax maps
	2641.44	Rec. D. Smith Survey
E-9 to E-8	2635.79	meas.
	2640.00	G.L.O.

C. Description of monument for corner and accessories established to perpetuate locating the position of the corner:

I replaced the found 1/2" iron pipe with a 4" x 36" concrete monument with a 2" diameter brass cap stamped "Oakland County Remonumentation PS 17632"

N. 80° W.	41.52'	P.K. Nail & O.C.R. tag S. face 30" Oak
N. 5° E.	56.93'	P.K. Nail & O.C.R. tag W. face 36" Oak
N. 30° E.	9.97'	P.K. Nail & O.C.R. tag N.W. face 32" Oak
Due East	5.95'	P.K. Nail & O.C.R. tag W. face 32" Oak

The selected location is accepted by me and generally accepted by Professional Surveyors as the best available evidence of the position of the original corner.



Signed by [Signature]

Date 12-20-95

Surveyor's Michigan License No. 17632

7.00
2.00
Bl