

COPY

SURVEY & REMONUMENTATION

LIBER 15397 PAGE 591

MAY 11 1995 084082

MAY 16 1996

COMMISSION

LAND CORNER RECORDATION CERTIFICATE

Filing Requirement of Act 74, Mich. P.A. 1970

For corners in Oakland

Commerce Twp.

(County)

Located In:

Corner Code #

1. Public Land Survey	T 2N	R 8E	E-11
	T	R	
	T	R	
	T	R	
2. Property Controlling in Section	S	T	R
	S	T	R
3. Miscellaneous Property in Sec.	S	T	R
	S	T	R

\$ 7.00 MISCELLANEOUS RECORDING

\$ 2.00 REMONUMENTATION


11 MAY 95 9:05 A.M. RECEIPT# 12B PAID RECORDED - OAKLAND COUNTY LYNN D. ALLEN, CLERK/REGISTER OF DEEDS

Compliance with ACT 345, P.A. 1990

APPROVED ON: 1-23-95 OAKLAND COUNTY REMONUMENTATION PEER GROUP COMMITTEE Register of Deeds Stamp & File Number

4. Lot No. , Recorded Plat 5. Private Claims

I, David Pawlaczyk in a field survey on December 5, 1994 do hereby certify that under requirements of P.A. 74, Michigan P.A. of 1970, the corner points mentioned in lines 1 and 2 above were in conformance with regulations and rules therefore as required in the current manual of survey instructions of the United States Department of the Interior, Bureau of Land Management or by a decree of a Court of Law and/or that the corner points mentioned in lines 3, 4 and 5 above were in conformance with the rules of the Michigan Board of Land Surveyors or by a Decree of a Court of Law; established, re-established, monumented, re-monumented, recovered, found as expressed below:

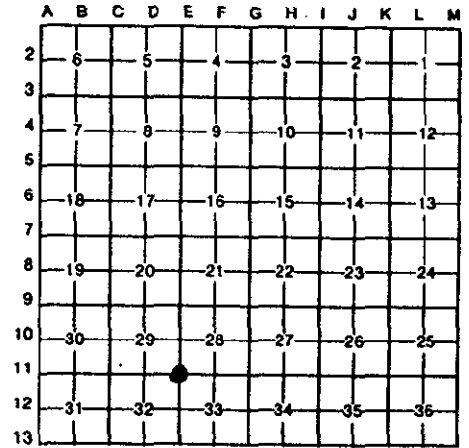

NOTE: Not more than 4 corners, all in the same town and range, may be recorded on this certificate.

A. Description of original monument and accessories and/or subsequent restoration:

Date	Monument	G.L.O.	Surveyor	Notes
1816	Post	A. Holmes	N/A	Notes
1973	1/2" Iron	J. Emig	#10059	L6133 P511
1976	1" Pipe	R. Kostecke	#12584	L6674 P386
1988	P.K. Nail	B. Thompson	#23828	L10771 P198
1988	P.K. Nail	B. Thompson	#23828	L10786 P52
1989	P.K. Nail	B. Thompson	#23828	L11866 P198
1989	P.K. Nail	C. Newman	#24607	Unrecorded
1990	P.K. Nail	B. Thompson	#23828	Unrecorded
1990	P.K. Nail	B. Thompson	#23828	L11355 P395
1990	P.K. Nail	B. Thompson	#23828	L11923 P8
1990	P.K. Nail	B. Thompson	#23828	L11996 P188
1993	P.K. Nail	B. Thompson	#23828	L13950 P648

Handwritten initials and date: 1/23/95

B. Description of corner evidence found and/or method applied in restoring or reestablishing corner:

A P.K. nail in asphalt pavement currently occupies this corner. The following witness ties were used to verify and recover its position:

- 2 ties match survey witnesses unrecorded (P.S.#10059)
- 3 ties match survey witnesses L6674 P386
- 4 ties match survey witnesses L11866 P198 & L10786 P52
- 3 ties match survey witnesses Unrecorded (P.S. #24607)
- 4 ties match L.C.R.C. L10771 P198, L11355 P395, L11887 P265 L11923 P8, L11996 P188, L13950 P648

Field measurements were made between the following corners:

From	To	Measurement	Method	G.L.O.	Notes
E-11	D-11	2649.35	meas.		
		2652.21	rec.	G.L.O.	Notes
		2649.34	rec.	Survey	L10786 P52

C. Description of monument for corner and accessories established to perpetuate locating the position of the corner:

I replaced the P.K. nail in asphalt pavement with a 5/8" x 24" iron rod with a 2" diameter brass cap stamped "Oakland County Remonumentation P.S. #17632" with a new monument box.

Direction	Distance	Notes
N.30° E.	46.14'	P.K. nail and O.C.R. tag in N.W. face D.E. pole
Due North	7.15'	Found "T" iron in asphalt pavement
Due North	27.98'	P.K. nail and O.C.R. tag in W. face D.E. pole
N.40° W.	48.16'	P.K. nail and O.C.R. tag in N.E. face 36" Oak
S.60° W.	61.80'	P.K. nail and O.C.R. tag in S.E. face D.E. pole

The selected location is accepted by me and generally accepted by Professional Surveyors as the best available evidence of the position of the original corner.

Signed by [Signature] Surveyor's Michigan License No. 17632

Date 2-16-95



OK - T. SMITH