

MAY 16 1996

COMMISSION

LIBER 15907 PG 732

Dec 27 95 257022

LAND CORNER RECORDATION CERTIFICATE
Filing Requirement of Act 74, Mich. P.A. 1970

For corners in

(County) Oakland Located In: Commerce Twp. Corner Code #

- 1. Public Land Survey T2N R8E F-1
2. Property Controlling in Section S T R
3. Miscellaneous Property in Section S T R
4. Lot No. , Recorded Plat
5. Private Claims

Compliance with ACT 345, P.A. 1990
APPROVED ON: 12-07-95 TB.
OAKLAND COUNTY REMONUMENTATION PEER GROUP COMMITTEE

Register of Deeds Stamp & File Number

Grid table with columns A-L and rows 1-13. A dot is marked at the intersection of column F and row 4.

I, David Pawlaczyk, in a field survey on October 11, 1995, do hereby certify that under requirements of P.A. 74, Michigan P.A. of 1970, the corner points mentioned in lines 1 and 2 above were in conformance with regulations and rules therefore as required in the current manual of survey instructions of the United States Department of the Interior, Bureau of Land Management or by a decree of a Court of Law and/or that the corner points mentioned in lines 3, 4 and 5 above were in conformance with the rules of the Michigan Board of Professional Surveyors or by a Decree of a Court of Law; established, re-established, monumented, re-monumented, recovered, found as expressed below:

NOTE: Not more than 4 corners, all in the same town and range, may be recorded on this certificate.

A. Description of original monument and accessories and/or subsequent restoration:

Table with 5 columns: Date, Description, Surveyor, File No., Notes. Includes entries for 1823 Post and 1991 Found 1/2" iron.

\$ 7.00 MISCELLANEOUS RECORDING
\$ 2.00 REMONUMENTATION
27 DEC 95 9:55 A.M. RECEIPT# 54B
PAID RECORDED - OAKLAND COUNTY
LYNN D. ALLEN, CLERK/REGISTER OF DEEDS

B. Description of corner evidence found and/or method applied in restoring or reestablishing corner:

A found concrete monument in a field currently occupies this corner. The following witness ties were used to recover and verify its position:

3 ties match L.C.R.C. L12163 P37


Field measurements were made between the following corners:

Table with 3 columns: Corner pair, Distance, Method. Includes E-1 to F-1 and F-1 to G-1.

C. Description of monument for corner and accessories established to perpetuate locating the position of the corner:

I placed a 2" diameter brass cap on the existing concrete monument:

Table with 3 columns: Angle, Distance, Description. Includes bearings like N 2° E and distances like 63.35'.

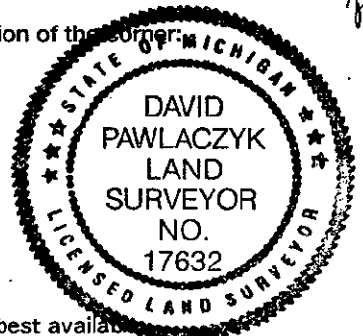

The selected location is accepted by me and generally accepted by Professional Surveyors as the best available evidence of the position of the original corner.

Signed by [Signature]

Date 12-20-95

Surveyor's Michigan License No. 17632