

MAY 16 1996

COMMISSION

LIBER 15907 PG 741

Dec 27 95 2 57 03 1

LAND CORNER RECORDATION CERTIFICATE
Filing Requirement of Act 74, Mich. P.A. 1970

For corners in


Located In: Corner Code #
(Oakland) Commerce Twp.

- 1. Public Land Survey T 2N R 8E F-5
2. Property Controlling in Section S T R
3. Miscellaneous Property in Section S T R

Compliance with ACT 345, P.A. 1990
APPROVED ON: 12-07-95 T.S.
OAKLAND COUNTY REMONUMENTATION PEER GROUP COMMITTEE

Register of Deeds Stamp & File Number

- 4. Lot No. , Recorded Plat
5. Private Claims

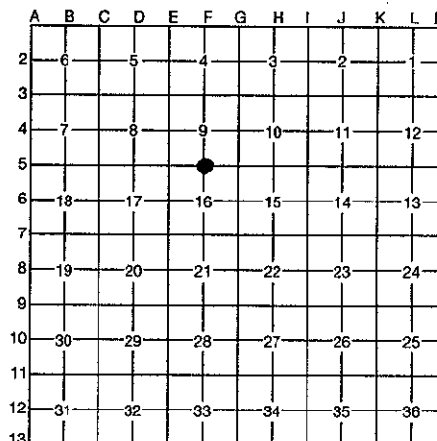

I, David Pawlaczyk, in a field survey on October 6, 1995, do hereby certify that under requirements of P.A. 74, Michigan P.A. of 1970, the corner points mentioned in lines 1 and 2 above were in conformance with regulations and rules therefore as required in the current manual of survey instructions of the United States Department of the Interior, Bureau of Land Management or by a decree of a Court of Law and/or that the corner points mentioned in lines 3, 4 and 5 above were in conformance with the rules of the Michigan Board of Professional Surveyors or by a Decree of a Court of Law; established, re-established, monumented, re-monumented, recovered, found as expressed below:

NOTE: Not more than 4 corners, all in the same town and range, may be recorded on this certificate.

A. Description of original monument and accessories and/or subsequent restoration:

Table with 4 columns: Year, Description, Surveyor, and File Number. Rows include 1823 Post (G.L.O. A. Holmes), 1990 Found 1" dia. pipe (L.C.R.C. D. Finney), and 1992 Found 1" pipe (Survey J. Scharl).

\$ 7.00 MISCELLANEOUS RECORDING
\$ 2.00 REMONUMENTATION
27 DEC 95 9:59 A.M. RECEIPT# 54B
PAID RECORDED - OAKLAND COUNTY
L13212 P41 TNN D. ALLEN, CLERK/REGISTER OF DEEDS

B. Description of corner evidence found and/or method applied in restoring or reestablishing corner:

A 1" diameter metal pipe in a field currently occupies this corner. The following witness ties were used to recover and verify its position:

Table with 4 columns: Ties, L.C.R.C., Witnesses, and File Numbers. Rows include 3 ties match (L.C.R.C.) and 3 ties match (Survey).


Field measurements were made between the following corners:

Table with 4 columns: Corner Pair, Distance, and Measurement Type. Rows include E-5 to F-5 (2692.66 meas., 2682.90 G.L.O., 2691.92 Rec. Survey L13212 P411, 2694.75 Rec. plats L207 P28) and F-5 to G-5 (2690.64 Meas., 2682.90 G.L.O., 2694.70 Plats L227 P6).

C. Description of monument for corner and accessories established to perpetuate locating the position of the corner:

I replaced the found 1" pipe with a 4" x 36" concrete monument with a 2" diameter brass disk stamped "Oakland County Remonumentation PS 17632"

Table with 4 columns: Bearing and Distance, and Monument Description. Rows include N. 20° W. 11.03' (P.K. Nail & O.C.R. tag N.E. face 4" Ash), N. 65° W. 20.03' (P.K. Nail & O.C.R. tag N. face 14" Cherry), S. 25° W. 5.17' (P.K. Nail & O.C.R. tag W. face 12" Ash), and N. 30° E. 6.93' (P.K. Nail & O.C.R. tag S.E. face 12" Ash).

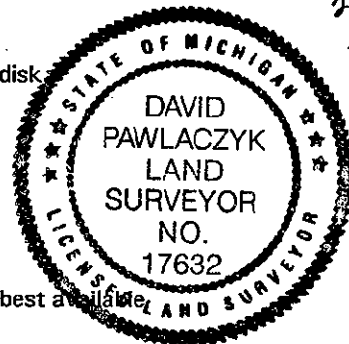

The selected location is accepted by me and generally accepted by Professional Surveyors as the best available evidence of the position of the original corner.

Signed by [Signature] Date 12-20-95

Surveyor's Michigan License No. 17632