

**SURVEY & REMONUMENTATION**

Dec 27 95 257021

MAY 16 1996

LIBER 15907 pg 731

**COMMISSION LAND CORNER RECORDATION CERTIFICATE**

Filing Requirement of Act 74, Mich. P.A. 1970

For corners in


Located In: Commerce Twp. Corner Code # F-9

- |                                      |                         |            |
|--------------------------------------|-------------------------|------------|
| 1. Public Land Survey                | T <u>2N</u> R <u>8E</u> | <u>F-9</u> |
|                                      | T _____ R _____         | _____      |
|                                      | T _____ R _____         | _____      |
|                                      | T _____ R _____         | _____      |
| 2. Property Controlling in Section   | S _____ T _____ R _____ | _____      |
|                                      | S _____ T _____ R _____ | _____      |
| 3. Miscellaneous Property in Section | S _____ T _____ R _____ | _____      |
|                                      | S _____ T _____ R _____ | _____      |

Compliance with ACT 345, P.A. 1990  
 APPROVED ON: 12-07-95 Tom S.  
 OAKLAND COUNTY REMONUMENTATION PEER GROUP COMMITTEE

Register of Deeds Stamp & File Number

4. Lot No. \_\_\_\_\_, Recorded Plat \_\_\_\_\_  
 5. Private Claims \_\_\_\_\_

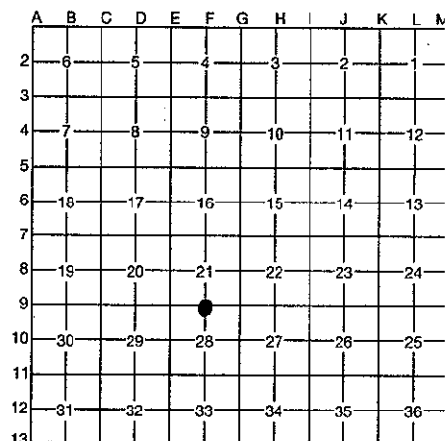

I, David Pawlaczyk, in a field survey on October 4, 1995, do hereby certify that under requirements of P.A. 74, Michigan P.A. of 1970, the corner points mentioned in lines 1 and 2 above were in conformance with regulations and rules therefore as required in the current manual of survey instructions of the United States Department of the Interior, Bureau of Land Management or by a decree of a Court of Law and/or that the corner points mentioned in lines 3, 4 and 5 above were in conformance with the rules of the Michigan Board of Professional Surveyors or by a Decree of a Court of Law; established, re-established, monumented, re-monumented, recovered, found as expressed below:

**NOTE: Not more than 4 corners, all in the same town and range, may be recorded on this certificate.**

**A. Description of original monument and accessories and/or subsequent restoration:**

1823 Post	G.L.O.	A. Holmes	N/A	Notes
1986 Found 1 1/2" dia. pipe, 2 1/2' high	Survey	B. Thompson	#23828	Unrecorded
1992 Found 2" pipe 3' above ground	L.C.R.C.	D. Smith	#33140	L13174 P139

\$ 7.00 MISCELLANEOUS RECORDING  
 \$ 2.00 REMONUMENTATION  
 27 DEC 95 9:55 A.M. RECEIPT# 54B  
 PAID RECORDED - OAKLAND COUNTY  
 LYNN D. ALLEN, CLERK/REGISTER OF DEEDS

**B. Description of corner evidence found and/or method applied in restoring or reestablishing corner:**

A found "T" iron 3' above ground and 2.2 feet east of a R.R. tie fence corner currently occupies this corner. The following witness ties were used to recover and verify its position:

3 ties match	L.C.R.C.	Witnesses	L13174 P139
2 ties match	Survey		Unrecorded

The following field measurements were made:

E-9 to F-9	2641.92	meas.
	2641.44	Rec. survey D Smith #33140 Unrecorded
	2644.76	O.C. Tax Maps

**C. Description of monument for corner and accessories established to perpetuate locating the position of the corner:**

I replaced the found "T" iron rod with a 4" x 36" concrete monument with a 2" diameter brass cap stamped "Oakland County Remonumentation PS 17632"

Due West 2.2'	Centerline upright R.R. tie fence post
S. 45° W. 29.37'	P.K. Nail & O.C.R. tag S.E. face 18" Oak
S. 10° W. 29.62'	P.K. Nail & O.C.R. tag W. face triple 12" Oaks
S. 30° E. 35.55'	P.K. Nail & O.C.R. tag N.E. face 20" Oak
Due East 11.92'	P.K. Nail & O.C.R. tag S. face 3rd R.R. tie East

The selected location is accepted by me and generally accepted by Professional Surveyors as the best available evidence of the position of the original corner.

Signed by [Signature]  
 Surveyor's Michigan License No. 17632

Date 12-20-95



7.00  
2.00  
file